

STATE OF KANSAS
STATE CORPORATION COMMISSION
200 Colorado Derby Building
Wichita, Kansas 67202

WELL PLUGGING RECORD
K.A.R.-82-3-117

API NUMBER 5-007-22488-0000

LEASE NAME MAGNISON

RECEIVED

JUN 13 2002

KCC WICHITA

TYPE OR PRINT

NOTICE: Fill out completely
and return to Cons. Div.
office within 30 days.

WELL NUMBER 1

2310 Ft. from S Section Line

2970 Ft. from E Section Line

LEASE OPERATOR Woolsey Petroleum Corp.

SEC. 23 TWP. 33 RGE. 13 (E) or (W)

ADDRESS 125 N. MARKET #1000 Wichita, KS 67202

COUNTY BARBER

PHONE# (316) 267-4379 OPERATORS LICENSE NO. 5506

Date Well Completed 12/18/95

Character of Well GAS

Plugging Commenced 6/7/02

(Oil, Gas, D&A, SWD, Input, Water Supply Well)

Plugging Completed 6/10/02

The plugging proposal was approved on JUNE 6, 2002 (date)

by KEVIN STRUBE (KCC District Agent's Name).

Is ACO-1 filed? YES If not, is well log attached? _____

Producing Formation SNYDERVILLE Depth to Top 3770' Bottom 3782' T.D. 5130'

Show depth and thickness of all water, oil and gas formations.

OIL, GAS OR WATER RECORDS

CASING RECORD

Formation	Content	From	To	Size	Put In	Pulled out
MISNER	WATER	SURF	225'	10 3/4"	225'	-0-
MISSISSIPPI	WATER-OIL-GAS	SURF	5122'	4 1/2"	5122'	3414'
MARMATON	WATER					
SNYDERVILLE	WATER-GAS					

Describe in detail the manner in which the well was plugged, indicating where the mud fluid was placed and the method or methods used in introducing it into the hole. If cement or other plugs were used, state the character of same and depth placed, from feet to feet each set.

SET WIRELINE. CIBP @ 3750'. PLUG 2 SAK CEMENT ON TOP w/ dump bailer. Got casing @ 3414' & TOOK. SPOT 50 SAK 60/40 PMIX @ 690'. SPOT 70 SAK SAME CEMENT @ 260'. SPOT 15 SAK SAME CEMENT @ 40'. Pull LAST JOINT & fill to SURFACE. USE TOTAL of 135 SAK.

(If additional description is necessary, use BACK of this form.)

Name of Plugging Contractor CLARKE CORPORATION License No. 5160

Address MEDICINE LODGE, KANSAS 67104

NAME OF PARTY RESPONSIBLE FOR PLUGGING FEES: Woolsey Petroleum Corporation


STATE OF KANSAS COUNTY OF BARBER, ss.

CARL W. DURE (Employee of Operator) or (Operator) of above-described well, being first duly sworn on oath, says: That I have knowledge of the facts, statements, and matters herein contained and the log of the above-described well as filed that the same are true and correct, so help me God.

(Signature) Carl W. Dure

(Address) PO Box 168 MEDICINE LODGE KS 67104

SUBSCRIBED AND SWORN TO before me this 11th day of June, 2002

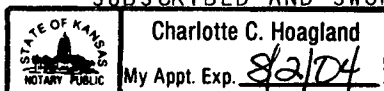

My Commission Expires: 8/2/04

Charlotte C Hoagland
Notary Public

15-007-22488-00-00

WELL COMPLETION SHEET

WELLBORE DIAGRAM

LEASE NAME & #: MAGNISON #1

DATE: 3-26-02

SEC. 23 T 33 S R 13 W

CSG SIZE: 4 1/2 10.5#


TYPE OF WELL-HEAD HERCULES w/STRIPPER

TBG SIZE: 2 3/8 4.7#

SUPERVISOR: Paul K. Shelton

TOTAL TBG: 3888.53

DEPTH OF TBG: 3898.63

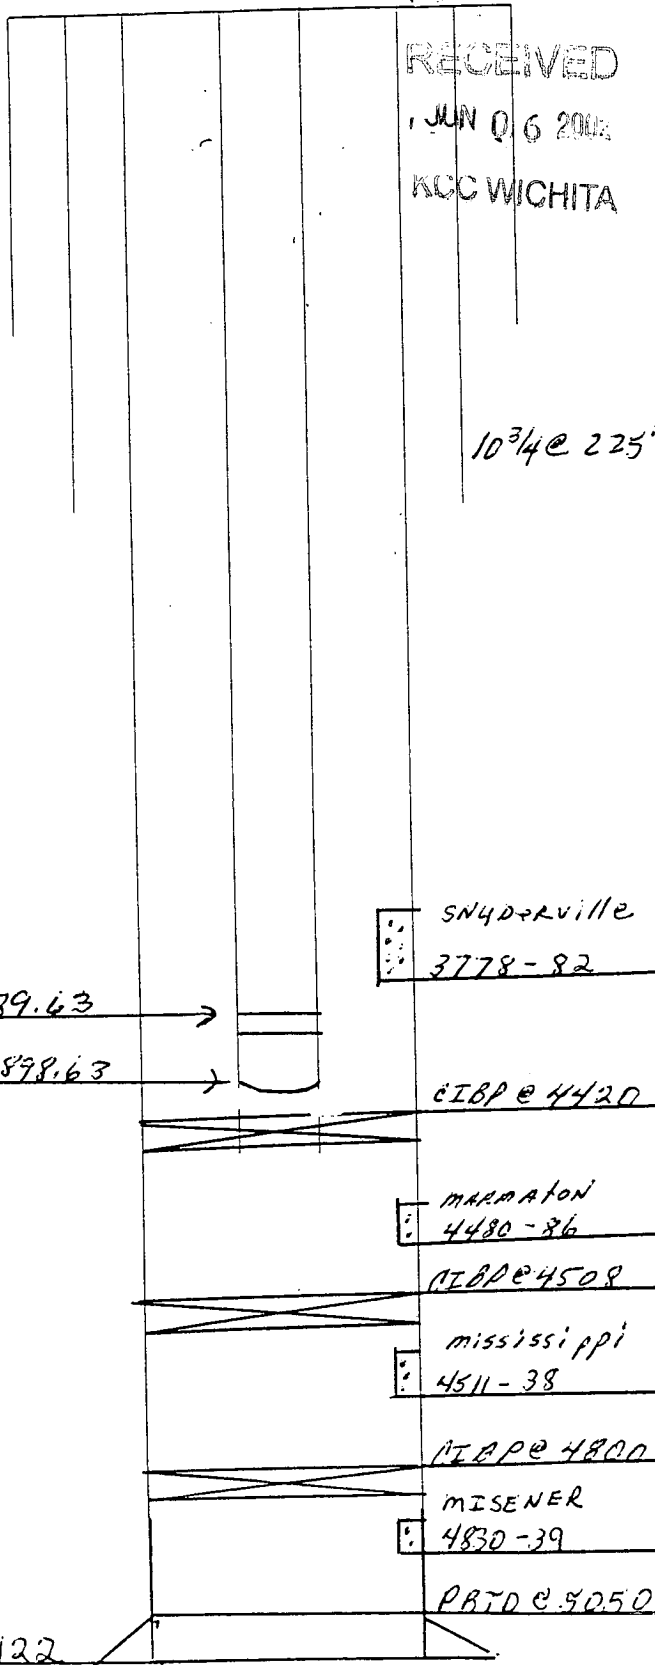

OF JTS: 126

TBG SUBS: NONE

PUMP SIZE: 2 X 1 1/4 X 12 RWB

PUMP #: Chrome ID

OF RODS: 154 - 3/4

PONY RODS: 2 - 4 - 8 X 3/4

ZERO: 9' AGL

PU BRAND: LUFKIN

SIZE: 114 SERIAL #: F62992J-403502

SPM: 4 1/2 SHEAVE SIZE: 24"

BELT SIZE & LENGTH: C-180

STROKE LENGTH: 54"

ENGINE BRAND & SIZE: C-96

SHEAVE SIZE: 8" RPM: 475

SERIAL #: 203481

H/T BRAND: NONE

WTR TNK SIZE: 12 X 10 FIBER GLASS

NET: CLOSED TOP:

STOCK TNK: 12 X 12 1/2 SERIAL #: 1H72901-03

SEPARATOR BRAND: MCDONALD

SIZE: 14" X 7'6" WP: 1000 PH: 2

REMARKS: _____
