


STATE OF KANSAS
STATE CORPORATION COMMISSION

WELL PLUGGING RECORD

Give All Information Completely
Make Required Affidavit
Mail or Deliver Report to:
Conservation Division
State Corporation Commission
P. O. Box 17027
Wichita, Kansas 67217
NORTH

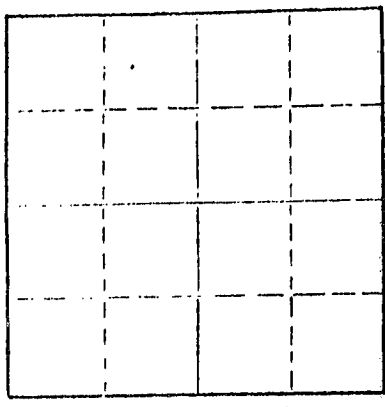

Ellis County, Sec. 18 Twp. 11S Rge. 17W (E) (W)
Location as "NE/CNW/SE/SW" or footage from lines ^{N2} SW SW
Lease Owner Clinton Oil Company
Lease Name J. Husted ~~SE~~ Well No. 5 ^{AUG KCC}
Office Address Wichita, Kansas 67202
Character of Well (completed as Oil, Gas or Dry Hole) O:1
Date well completed 11-1 19 40
Application for plugging filed 6-27 19 74
Application for plugging approved 7-11 19 74
Plugging commenced 8/13/74 19
Plugging completed 8/16/74 19
Reason for abandonment of well or producing formation depleted.

If a producing well is abandoned, date of last production November 26 19 72
Was permission obtained from the Conservation Division or its agents before plugging was commenced? yes

Name of Conservation Agent who supervised plugging of this well Massey
Producing formation _____ Depth to top _____ Bottom _____ Total Depth of Well 3343 Feet
Show depth and thickness of all water, oil and gas formations.

OIL, GAS OR WATER RECORDS

CASING RECORD

FORMATION	CONTENT	FROM	TO	SIZE	PUT IN	PULLED OUT
				15 1/2	26'	none
				10'	1100'	none
				7"	2332'	2329 2309'

Describe in detail the manner in which the well was plugged, indicating where the mud fluid was placed and the method or methods used in introducing it into the hole. If cement or other plugs were used, state the character of same and depth placed, from _____ feet to _____ feet for each plug set.

Ran sand to 3300' and ran 5 sacks cement. Shot pipe at 2318', pulled 78 joints. Set rock bridge at 365 to 350' and ran 7 yards ready mix.

PLUGGING COMPLETE.

RECEIVED
STATE CORPORATION COMMISSION

SEP 24 1974

CONSERVATION DIVISION
Wichita, Kansas

(If additional description is necessary, use BACK of this sheet)

Name of Plugging Contractor KELSO CASING PULLING
Address CHASE, KANSAS

STATE OF KANSAS COUNTY OF RICE
R. DARRELL KELSO (employee of owner) or (owner or operator) of the above-described

well, being first duly sworn on oath, says: That I have knowledgo of the facts, statements, and matters herein contained and the log of the above-described well as filed and that the same are true and correct. So help me God.

(Signature) R. Darrell Kelso
CHASE, KANSAS

SUBSCRIBED AND SWORN TO before me this 20th day of August, 19 74

MARGARET MELCHER
NOTARY PUBLIC
Rice County, Kansas
My Commission Expires
Feb. 15, 1975

Margaret Melcher
Notary Public.

15-051-02217-0000

THE DICKHY OIL COMPANY
WICHITA, KANSAS

Husted No. 5.

COMMENCED: 10/10/40
COMPLETED: 11/ 1/40

LOCATION: C/N $\frac{1}{2}$ SW $\frac{1}{4}$ SW $\frac{1}{4}$ 18-11-17
ELEVATION: 1842

26' 15 $\frac{1}{2}$ "
1100' 10"
3332' 7"

LOG ACCORDING TO DRILLERS LOG

surface sand	20
post rock	35
shale and shells	495
iron	505
shale and shells	610
water sand	750
shale	823
red bed	1083
anhydrite	1120
shale and shells	1450
alt	1580
shale and shells	1690
shale and lime	1847
broken lime	1980
lime	2187
broken lime	2210
shale	2255
shale and lime	2325
shale and shells	2800
top Topeka	2800
lime	3110
top K.C.	3110
lime	3300
red bed	3321
green shale	3331
top Arbuckle	3331D.F.
T.D.	3343

RECEIVED
STATE CORPORATION COMMISSION
JUL 11 1974
CONSERVATION DIVISION
Wichita, Kansas