


STATE OF KANSAS  
STATE CORPORATION COMMISSION

WELL PLUGGING RECORD

Give All Information Completely  
Make Required Affidavit  
Mail or Deliver Report to  
Conservation Division  
State Corporation Comm.  
245 North Water  
Wichita, KS 67202

Ellis County, Sec. 18 Twp. 11S Rge. 17 E/W  
Location as "NE/CNW $\frac{1}{4}$ /SW $\frac{1}{4}$ " or footage from lines  
S/2 SW NE

Lease Owner Energy Reserves Group  
Lease Name Kollman Well No. 2  
Office Address 925 Patton Road, Great Bend, KS. 67530  
Character of Well (Completed as Oil, Gas or Dry Hole) Oil

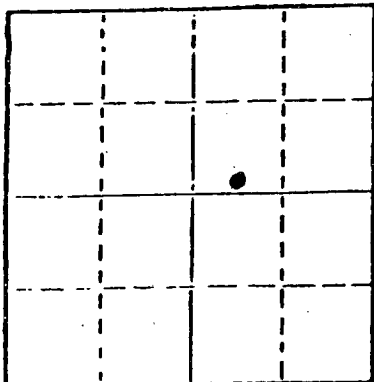

Locate well correctly on above  
Section Plat

Date Well completed 3-11 1940  
Application for plugging filed 3-26 1982  
Application for plugging approved 3-30 1982  
Plugging commenced 5-12 1982  
Plugging completed 5-12 1982

Reason for abandonment of well or producing formation  
Casing leak uneconomical to repair  
If a producing well is abandoned, date of last production 8-24 1977

Was permission obtained from the Conservation Division or  
its agents before plugging was commenced? Yes

Name of Conservation Agent who supervised plugging of this well Gibb Scheck  
Producing formation Arbuckle Depth to top 3358 Bottom 3420 Total Depth of Well 3426  
Show depth and thickness of all water, oil and gas formations.

OIL, GAS OR WATER RECORDS

CASING RECORD

FORMATION	CONTENT	FROM	TO	SIZE	PUT IN	PULLED OUT
Arbuckle	Oil & Water	3358	3420	15 1/2	34	0
				10 3/4	1116	0
				7	3360	0
				5	181	0

Describe in detail the manner in which the well was plugged, indicating where the mud fluid was placed and the method or methods used in introducing it into the hold. If cement or other plugs were used, state the character of same and depth placed, from feet to feet for each plug set.

Order of plugging - 4 sx bulls, 15 sx gel, 70 sx cmt, 4 sx gel, 1 sx bulls, a 7" plug, 70 sx cmt.

Plugged with 140 sx 50/50 poz, 4% gel, 3% cc, 19 sx gel, 5 sx hulls, a 7" plug

(If additional description is necessary, use BACK of this sheet)

Name of Plugging Contractor Halliburton & Ostrom Well Service

STATE OF Kansas COUNTY OF Barton, ss.  
Jim W. Sullivan (employee of owner) or (owner or operator)  
of the above-described well, being first duly sworn on oath, says: That I have knowledge of the facts, statements, and matters herein contained and the log of the above-described well as filed and that the same are true and correct. So help me God.

(Signature)


Jim W. Sullivan  
925 Patton Rd, Great Bend, KS 67530  
(Address)

SUBSCRIBED AND SWORN TO before me this 3rd day of June, 1982

Ronald E. Rowe  
Notary Public.

My commission expires My Appointment Expires Sept. 9, 1983

RECEIVED  
STATE CORPORATION COMMISSION  
JUN - 7 1982  
CONSERVATION DIVISION  
Wichita, Kansas

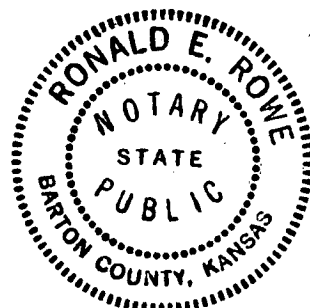

THE DICKEY OIL COMPANY  
Kollman Well No. 2

COMMENCED: 2/15/40  
COMPLETED: 3/11/40

LOCATION: C/S/2 NE/4 1811-17  
Ellis County, Kansas  
ELEVATION: 1859

S.W.

Casing Record

15 1/2" 34'  
10" 1116'  
7" 3360'

surface	34
shale and shells	510
iron	540
shale and shells	650
sand	764
red bed	1110
anhydrite	1145
shale and shells	1375
shale	1450
salt	1660
shale and shells	1812
broken lime	1970
lime	2023
broken lime	2275
shale and shells	2365
broken lime	2428
shale and shells	2800
top Topeka lime	2800
lime	3012
top K.C. lime	3012
lime	3316
red bed	3326
conglomerate	3337
Simpson dolomite	3345
green shale	3359
top Arbuckle	3360
lime	3370 T.D.

8-56 deepened to 3477'

RECEIVED  
STATE CORPORATION COMMISSION  
MAR 29 1982  
CONSERVATION DIVISION  
Wichita Kansas