


Give All Information Completely  
Make Required Affidavit  
Mail or Deliver Report to:  
Conservation Division  
State Corporation Commission  
211 No. Broadway  
Wichita, Kansas

WELL PLUGGING RECORD

NORTH

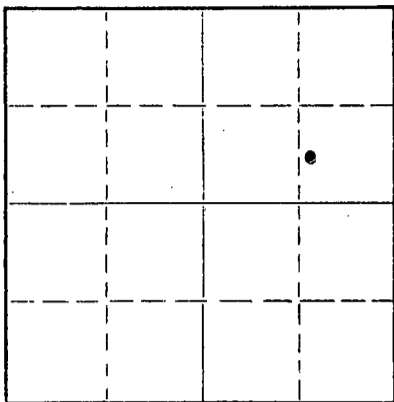

Locate well correctly on above Section Plat

Ellis County. Sec. 18 Twp. 11 Rge. 17 (E) 17 (W)  
Location as "NE/CNW/SW" or footage from lines C W/2 SE 1/4 NE 1/4  
Lease Owner Pan American Petroleum Corporation  
Lease Name Noni Kollman Well No. 5  
Office Address Box 548 - Ellinwood, Kansas  
Character of Well (completed as Oil, Gas or Dry Hole) Oil  
Date well completed 2/27/19 61  
Application for plugging filed 2/25/1961  
Application for plugging approved 2/28/19 61  
Plugging commenced 4/ 7/19 61  
Plugging completed 4/11/19 61  
Reason for abandonment of well or producing formation Economically depleted

If a producing well is abandoned, date of last production 1/6/19 61  
Was permission obtained from the Conservation Division or its agents before plugging was commenced? Yes

Name of Conservation Agent who supervised plugging of this well Mr. Eldon Petty  
Producing formation Arbuckle Depth to top 3342 Bottom 3351 Total Depth of Well 3351 Feet  
Show depth and thickness of all water, oil and gas formations.

OIL, GAS OR WATER RECORDS

CASING RECORD

FORMATION	CONTENT	FROM	TO	SIZE	PUT IN	PULLED OUT
<u>Arbuckle</u>	<u>Oil</u>	<u>0</u>	<u>55</u>	<u>15-1/2"</u>	<u>55</u>	<u>0</u>
		<u>0</u>	<u>1100</u>	<u>10-3/4"</u>	<u>1100</u>	<u>0</u>
	<u>Depleted</u>	<u>0</u>	<u>3342</u>	<u>7"</u>	<u>3342</u>	<u>2447'</u>

Describe in detail the manner in which the well was plugged, indicating where the mud fluid was placed and the method or methods used in introducing it into the hole. If cement or other plugs were used, state the character of same and depth placed, from \_\_\_\_\_ feet to \_\_\_\_\_ feet for each plug set.

3342-350 - Heavy Mud  
350-150 - 20 SX Cement  
150- 20 - Heavy Mud  
Ran 10 SX Cement to base of cellar.

RECORDED  
STATE CORPORATION COMMISSION  
APR 20 1961  
CONSERVATION DIVISION

(If additional description is necessary, use BACK of this sheet)

Name of Plugging Contractor Knight Casing Pulling Co.  
Address Chase, Kansas

STATE OF Kansas, COUNTY OF Barton, ss. G. A. Reynolds (employee of owner) or (owner or operator) of the above-described well, being first duly sworn on oath, says: That I have knowledge of the facts, statements, and matters herein contained and the log of the above-described well as filed and that the same are true and correct. So help me God.

(Signature) G. A. Reynolds  
Box 548 - Ellinwood, Kansas  
(Address)

SUBSCRIBED AND SWORN TO before me this 27th day of April, 1961

Lovie J. Matherson  
Notary Public.

My commission expires January 9, 1965



10

15-051-19330-009

*Pan American*

THE DICKEY OIL COMPANY  
Kollman #5

COMMENCED: 2-7-41  
COMPLETED: 2-27-41

LOCATION: C/4 SE 1/4 NE 1/4 18-11-17  
Ellis County, Kansas  
ELEVATION:

Pipe Record

	55'	15 1/2"
	1100'	10"
	3342'	7"
		40
		35
Shale and Shells		493
Iron		525
Shale		600
Water and Sand		740
Red Bed		1085
Anhydrite		1120
Shale and Shells		1430
Salt		1616
Shale and Shells		2045
Shale and Lime		2175
Shale and Shells		2775
Top Topeka		2775
Oil Showing	2802-2814	
Topeka Lime		2644
Lime and Shale		2900
Oil Smell	2931-2944	
Oil Smell	2961-2972	
Lime		3010
Broken Lime		3070
Top K. C. Lime		3070
Oil Showing	3083-3092	
Oil Showing	3137-3145	
Oil Smell	3181-3189	
Lime		3292
Top Conglomerate		3292
Conglomerate		3329
Green Shale		3342 1/2
Top Arbuckle		3342 1/2
Arbuckle		3351 T.D.

RECEIVED  
STATE CORPORATION COMMISSION  
MAY 1 1941  
CONSERVATION DIVISION  
Wichita, Kansas

NOTE: Top Siliceous is 3341 1/2'  
(Corrected to Derrick Floor)

CORRECTION:

Lime	3291
Conglomerate	3328
Green Shale	3341 1/2
Top Arbuckle	3341 1/2
Arbuckle	3351