

STATE OF KANSAS  
STATE CORPORATION COMMISSION  
CONSERVATION DIVISION  
P. O. BOX 17027  
WICHITA, KANSAS 67217

FORM CP-4

WELL PLUGGING RECORD

Ellis County, Sec 19 Twp 11 Rge 17 (E) (W)

Location as "NE/CNWSW2" or footage from lines S.E.-S.W.-S.E.

Lease Owner Patton Oil Company

Lease Name Peavey Well No. B 1

Office Address 3333 South Bannock Englewood, Colo. 80110

Character of Well (completed as Oil, Gas or Dry Hole) Oil

Date well completed March 19 57

Application for plugging filed June 5, 19 75

Application for plugging approved June 9, 19 75


Plugging commenced July 16, 19 75

Plugging completed July 16, 19 75

Reason for abandonment of well or producing formation Production not profitable.

If a producing well is abandoned, date of last production May, 19 73

Was permission obtained from the Conservation Division or its agents before plugging was commenced? yes

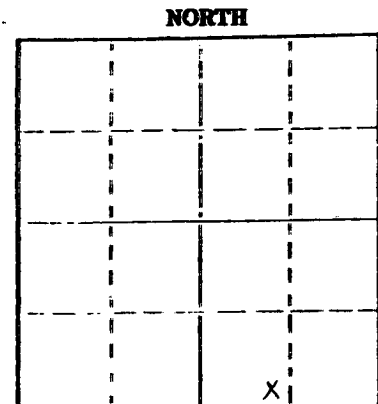

Locate well correctly on above Section Plat

Name of Conservation Agent who supervised plugging of this well Leo Massey

Producing formation Arbuckle Depth to top 3512' Bottom 3525' Total Depth of Well 3525'

Show depth and thickness of all water, oil and gas formations.

OIL, GAS OR WATER RECORDS

CASING RECORD

FORMATION	CONTENT	FROM	TO	SIZE	FEET IN	PURLED OUT
Arbuckle	Oil & Water	3518'	3525'	8 5/8"	232'	None
				5 1/2"	3518'	"

Describe in detail the manner in which the well was plugged, indicating where the mud fluid was placed and the method or methods used in introducing it into the hole. If cement or other plugs were used, state the character of same and depth placed, from \_\_\_\_\_ feet to \_\_\_\_\_ feet for each plug set.

Allied Cementing Co. Pumped 25 sxs. cement, 3 sxs hulls, 30 sxs Gel, 1 rubber plug and 50 sxs cement on top.

(If additional description is necessary, use BACK of this sheet)

Name of Plugging Contractor Allied Cementing Co.

Address Russell, Kansas

STATE OF \_\_\_\_\_ COUNTY OF \_\_\_\_\_, ss.

(employee of owner) or (owner or operator) of the above-described well, being first duly sworn on oath, says: That I have knowledge of the facts, statements, and matters herein contained and the log of the above-described well as filed and that the same are true and correct. So help me God.

(Signature) Albert R. Reed

692 West 4th Street Herington Kansas

(Address)

Subscribed and sworn to before me this 15 day of Aug 19 75

3/25/79

Alberta L. Reed Notary Public.

RECEIVED  
STATE CORPORATION COMMISSION

AUG 18 1975

CONSERVATION DIVISION  
Wichita, Kansas



15-051-01353-0000  
**WELL LOG BUREAU—KANSAS GEOLOGICAL SOCIETY**  
 508 East Murdock, Wichita, Kansas


**COPY**

Company- MURFIN DRILLING COMPANY  
 Farm- Peavey "B" No. 1

SEC. 19 T. 11 R. 17W  
 SE SW SE

Total Depth. 3525'  
 Comm. 11-28-56 Comp. 12-9-56  
 Shot or Treated.  
 Contractor. Murfin Drilling Company  
 Issued. 3-9-57

County Ellis KANSAS

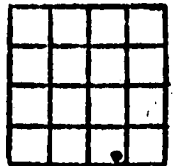

Elevation. 1977' RB

Production. 25 BOPD

Figures indicate Bottom of Formations.

**CASING:**

8" @232' w/150 sx cem.	
5" @3518' w/75 sx cem.	
shale, shells	510
Pyrite sand,	
shells	605
sand, pyrite	640
shale, sand	720
sand	890
iron	930
red bed shale	1221
Anhydrite	1255
red rock, shale	
shells	1500
shale, shells	1585
salt, shale	1725
shale, lime	1745
shale, lime,	
shells	1835
lime, shale	3198
lime	3482
shale, lime	3512
lime, Arbuckle	3525 RTD
Total Depth	

**TOPS**

Anhydrite	1221
Topoka	2925
Heebner	3159
Lansing	3204
Conglomerate	3482
Arbuckle	3512

**DRILL STEM TEST**  
 DST. #1 3341-78, Op. 1 hr.  
 Rec. 30 mud BHP 790#

RECEIVED  
 STATE CORPORATION COMMISSION

06-09-75  
 CONSERVATION DIVISION  
 Wichita, Kansas