


WELL PLUGGING RECORD

Give All Information Completely  
Make Required Affidavit  
Mail or Deliver Report to:  
Conservation Division  
State Corporation Commission  
212 No. Market  
Wichita, Kansas

Ellis County. Sec. 19 Twp. 11 Rge. (E) 17 (W)

Location as "NE/CNW/SE/SW" or footage from lines. W/2 SW NW  
Lease Owner SUN OIL COMPANY  
Lease Name Peavey "D" Well No. 2  
Office Address 800 Security Life Building, Denver, Colorado 80202  
Character of Well (completed as Oil, Gas or Dry Hole) Oil  
Date well completed April 14 1946  
Application for plugging filed December 12 1973  
Application for plugging approved December 14 1973  
Plugging commenced August 7 1974  
Plugging completed August 10 1974  
Reason for abandonment of well or producing formation Depleted

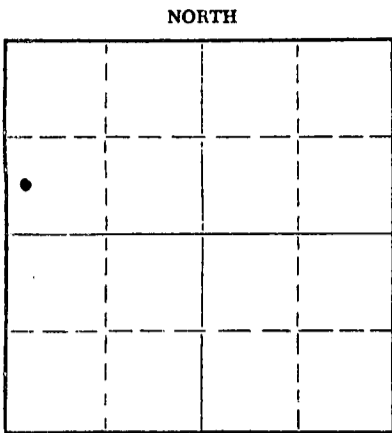

Locate well correctly on above Section Plat

If a producing well is abandoned, date of last production Unknown 19  
Was permission obtained from the Conservation Division or its agents before plugging was commenced? Yes

Name of Conservation Agent who supervised plugging of this well Leo Massey  
Producing formation Toronto Depth to top 3064 Bottom 3072 Total Depth of Well 3361 Feet  
Show depth and thickness of all water, oil and gas formations.

OIL, GAS OR WATER RECORDS

CASING RECORD

FORMATION	CONTENT	FROM	TO	SIZE	PUT IN	PULLED OUT
				13 3/8	120	-
				8 5/8	1110	-
				5 1/2	3357	2250

Describe in detail the manner in which the well was plugged, indicating where the mud fluid was placed and the method or methods used in introducing it into the hole. If cement or other plugs were used, state the character of same and depth placed, from \_\_\_\_\_ feet to \_\_\_\_\_ feet for each plug set.

Set plug at 3000 with 2 ft. rock bridge. Dumped 4 sxs. cement on plug at 3000'. Shot 5 1/2" casing at 2250 ft. Pulled 70 jts. of 5 1/2" casing (2250'). Set plug at 365' with rock and sand bridge. Plugged with 5 yds. of readymix concrete.

RECEIVED  
STATE CORPORATION COMMISSION  
SEP 11 1974  
CONSERVATION DIVISION  
Wichita, Kansas  
09-05-74

(If additional description is necessary, use BACK of this sheet)


Name of Plugging Contractor Charlie Crow Drilling Company  
Address Box 706, Hays, Kansas

STATE OF COLORADO, COUNTY OF DENVER, ss.  
D. A. COPPEDGE (employee of owner) or (owner or operator) of the above-described well, being first duly sworn on oath, says: That I have knowledge of the facts, statements, and matters herein contained and the log of the above-described well as filed and that the same are true and correct. So help me God.

(Signature) [Signature] D. A. Coppedge  
800 Security Life Building, Denver CO 80202  
(Address)

SUBSCRIBED AND SWORN to before me this 26<sup>th</sup> day of August, 19 74

My commission expires Nov. 22, 1975 Notary Public. Mary Marston

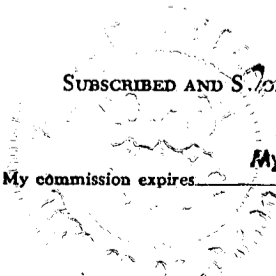

15-051-03327-0000

SUNRAY OIL CORPORATION

STICKLE DRILLING COMPANY  
WELL LOG

PEAVEY D #2  
W/2 SW NW Sec.19-11S-17W  
Ellis County, Kansas

Clay and sand	0	-	65
Shale and shells	65	-	490
Sand and pyrites	490	-	545
Shale and shells	545	-	605
Shale, shells & sand	605	-	750
Red beds and lime shells	750	-	915
Red beds and pyrite	915	-	960
Shale and pyrite	906	-	1103
Anhydrite	1103	-	1150
Red beds	1150	-	1350
Salt and shale	1350	-	1500
Shale and shells	1500	-	1680
Shale and lime	1680	-	2000
Lime	2000	-	2135
Lime and shale	2135	-	2255
Lime - broken	2255	-	2345
Lime and shale	2345	-	2620
Lime	2620	-	2690
Shale and lime	2690	-	2953
Lime	2953	-	3009
Shale and lime	3009	-	3040
Lime	3040	-	3206
Lime and shale	3206	-	3252
Lime	3252	-	3332
Lime and conglomerate	3332	-	3361

RECEIVED  
STATE CORPORATION COMMISSION  
DEC 14 1973  
CONSERVATION DIVISION  
Wichita, Kansas

STATE OF OKLAHOMA )  
( SS  
COUNTY OF TULSA )

I, F. E. Stickle, first being duly sworn, state that the above and foregoing log is a true and correct log made from the drilling reports on the above-mentioned well.

F. E. Stickle

Subscribed and sworn to before me this 30th day of April, 1946.

Katherine Myra  
Notary Public

My commission expires:  
October 19, 1948