

CARD MUST BE TYPED

State of Kansas
NOTICE OF INTENTION TO DRILL
(see rules on reverse side)

CARD MUST BE SIGNED

Starting Date: 3 11 85
month day year 9/14

API Number IS- 167-22,581-00-00

OPERATOR: License # 7124
Name H & H PRODUCTION, INC.
Address P. O. Box 348
City/State/Zip Russell, Kansas 67665
Contact Person Rudy A. Herman
Phone 913/483-4898

NE NE SE Sec 27 Twp 13 S, Rge 15
(location) East West

CONTRACTOR: License # 5929
Name DUKE DRILLING CO., INC.
City/State Great Bend, Kansas 67530

..... 2310 Ft North from Southeast Corner of Section
..... 330 Ft West from Southeast Corner of Section
(Note: Locate well on Section Plat on reverse side)

Well Drilled For: Well Class: Type Equipment:
 Oil Swd Infield Mud Rotary
 Gas Inj Pool Ext. Air Rotary
 OWWO Expl Wildcat Cable

Nearest lease or unit boundary line 330 feet.
County Russell
Lease Name Lydia Dumler Well# 1
Domestic well within 330 feet: yes no
Municipal well within one mile: yes no

If OWWO: old well info as follows:

Operator
Well Name
Comp Date Old Total Depth
Projected Total Depth 3350 feet
Projected Formation at TD Arbuckle
Expected Producing Formations Arbuckle

Depth to Bottom of fresh water 225 feet
Lowest usable water formation Dakota
Depth to Bottom of usable water 450 feet
Surface pipe by Alternate: 1 2
Surface pipe to be set 450+ feet
Conductor pipe if any required feet
Ground surface elevation 1900 feet MSL
This Authorization Expires 9-7-85
Approved By 3-7-85

I certify that we will comply with K.S.A. 55-101, et seq., plus eventually plugging hole to K.C.C. specifications.

Date 3/6/85 Signature of Operator or Agent

Sally R. Byers
Sally R. Byers

Title Agent


Form C-1 4/84

MHC/KOHE 3-8-85

Must be filed with the K.C.C. five (5) days prior to commencing well
 This card void if drilling not started within six (6) months of date received by K.C.C.

Important procedures to follow :

A Regular Section of Land
1 Mile = 5,280 Ft.

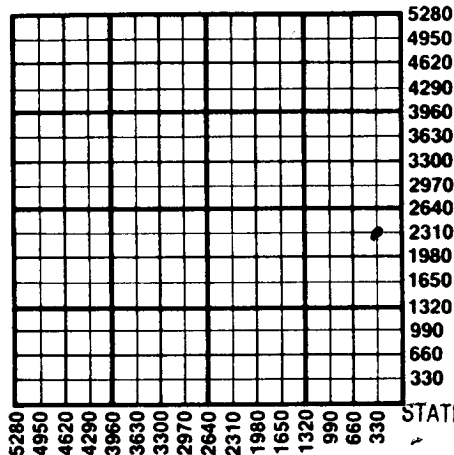

1. Notify District office before setting surface casing.
2. Set surface casing by circulating cement to the top.
3. File completion forms ACO-1 with K.C.C. within 90 days of well completion, following instructions on ACO-1, side 1, and including copies of wireline logs.
4. Notify District office 48 hours prior to old well workover or re-entry.
5. Prior to plugging, prepare a plugging plan, then obtain agreement from the appropriate district office for an approved plugging plan.
6. Submit plugging report (CP-4) to K.C.C. after plugging is completed.
7. Obtain an approved injection docket number before disposing of salt water.
8. Notify K.C.C. within 10 days when injection commences or terminates.
9. If an alternate 2 completion, cement in the production pipe from below any usable water to surface within 120 days of spud date.

RECEIVED

STATE CORPORATION COMMISSION

State Corporation Commission of Kansas
 Conservation Division
 200 Colorado Derby Building
 Wichita, Kansas 67202
 (316) 263-3238

MAR 7 1985
 03-07-1985
 CONSERVATION DIVISION
 Wichita, Kansas