


STATE OF KANSAS
STATE CORPORATION COMMISSION

WELL PLUGGING RECORD

Give All Information Completely
Make Required Affidavit
Mail or Deliver Report to
Conservation Division
State Corporation Comm.
245 North Water
Wichita, KS 67202

Ness County, Sec. 22 Twp. 16S Rge. 26 E/W
Location as "NE/CNW $\frac{1}{4}$ /SW $\frac{1}{4}$ " or footage from lines
C SE SE

Lease Owner Pickrell Drilling Company
Lease Name Evel "I" Well No. 1
Office Address 205 Litwin Bldg., Wichita, Kansas
Character of Well (Completed as Oil, Gas or Dry Hole) 67202
oil

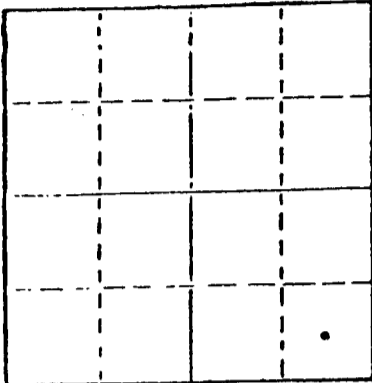

Locate well correctly on above
Section Plot

Date Well completed _____ 19____
Application for plugging filed Dec. 30 1976
Application for plugging approved _____ 19____
Plugging commenced Feb. 9 1977
Plugging completed Feb. 17 1977
Reason for abandonment of well or producing formation
depleted

If a producing well is abandoned, date of last production
_____ 19____

Was permission obtained from the Conservation Division or
its agents before plugging was commenced? yes

Name of Conservation Agent who supervised plugging of this well Leo Massey
Producing formation _____ Depth to top _____ Bottom _____ Total Depth of Well 4575'
Show depth and thickness of all water, oil and gas formations.

OIL, GAS OR WATER RECORDS

CASING RECORD

FORMATION	CONTENT	FROM	TO	SIZE	PUT IN	PULLED OUT
			266'	8 5/8"	266'	none
			4563'	5 1/2"	4563'	1031.73

Describe in detail the manner in which the well was plugged, indicating where the mud fluid
was placed and the method or methods used in introducing it into the hold. If cement or other
plugs were used, state the character of same and depth placed, from _____ feet to
_____ feet for each plug set.

Sanded back to 4550' and dumped 4 sacks of cement.

Allied Cementing Company plugged well pumping in 1 sack of hulls, 25 sacks
of gel and 120 sacks of cement.

FEB 25 1977
02-25-77

CONSERVATION DIVISION

(If additional description is necessary, use BACK of this sheet)

Name of Plugging Contractor PIPE PULLERS, INC.
Box 128, Ellinwood, Kansas 67526

STATE OF KANSAS COUNTY OF BARTON, ss.
Evelyn Roth (employee of owner) or (~~owner or operator~~)
of the above-described well, being first duly sworn on oath, says: That I have knowledge of
the facts, statements, and matters herein contained and the log of the above-described well
as filed and that the same are true and correct. So help me God.

(Signature) Evelyn Roth
Ellinwood, Kansas
(Address)

SUBSCRIBED AND SWORN TO before me this 22 day of February, 1977

My commission expires _____

JENNY KASSELMAN
NOTARY PUBLIC
BARTON COUNTY, KANSAS
MY COMM. EXP. JULY 16, 1978

Jenny Kasselmann
Notary Public.

ROTARY DRILLING LOG 15-135-20571-0000

COMPANY: Pickrell Drilling Company
705 Fourth National Bank Building
Wichita, Kansas 67202

Rotary Drilling Commenced 2/9/72
Rotary Drilling Completed 2/19/72

LOCATION: Evel "I" No. 1, C SE SE Section 22-16S-26W
Ness County, Kansas

CONTRACTOR: **PICKRELL DRILLING COMPANY**
Wichita, Kansas

CASING RECORD: Run 7 Jts. 8-5/8" surface casing set @ 266' KB. Cemented w/150 sacks cement. Completed 8:30 P.M. Circulated.

Ran 136 Jts. 5-1/2" casing set @ 4563'. Cemented w/125 sacks 50-50 pozmix, 4% gel followed by 35 sacks common. Plug down 7:30 P.M. February 19, 1972.

LOG

(Figures indicate bottom of formation — measurements from top of rotary bushing.)

40	Sandy Clay		C.F.S.
100	Clay - Post Rock		4140
270	Shale - Sand Streaks		4225
875	Shale		4325
915	Sand		4350
955	Shale		4480
990	Sand		4545
1300	Shale - Shells		4555
1490	Shale		4570
1750	Sand		4575
2038	Shale		
2083	Anhydrite		
2310	Shale		S.L.M.
2800	Lime & Shale	Board	3848.70
3340	Lime	Strap	3848.01
3560	Lime & Shale		.69 Short
3900	Shale & Lime		
4518	Lime		
4555	Lime - Chert		
4575	Lime, RTD		
		Slope Tests	
			2000
			2500
			3000
			3500
			4000
			4500

RECEIVED
STATE CORPORATION COMMISSION
JAN 04 1977
CONSERVATION DIVISION
Wichita, Kansas

The undersigned, C. W. Sebitts, Attorney-in-Fact for PICKRELL DRILLING COMPANY, hereby certifies in behalf of said Company, that the above is a true and correct log of the formation encountered in drilling the above well as reflected by the Daily Drilling Reports.


PICKRELL DRILLING COMPANY
By: [Signature]
C. W. SEBITTS, Attorney-in-Fact

STATE OF KANSAS }
COUNTY OF SEDGWICK } ss.:

On this 22nd day of February, 19 72, before me the undersigned, a Notary Public, in and for

the County and State aforesaid, personally appeared C. W. Sebitts, to me known to be the identical person who subscribed the name of PICKRELL DRILLING COMPANY to the foregoing instrument as its Attorney-in-Fact and acknowledged to me that he executed the same as his free and voluntary act and deed, and as the free and voluntary act and deed of such company, for the uses and purposes therein set forth.

Given under my hand and seal of office the day and year last above written.

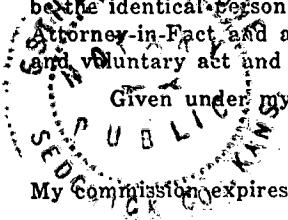

My Commission expires: January 19, 1973

[Signature]
Esther Lamone
Notary Public