


STATE OF KANSAS  
STATE CORPORATION COMMISSION

WELL PLUGGING RECORD

Give All Information Completely  
Make Required Affidavit  
Mail or Deliver Report to  
Conservation Division  
State Corporation Comm.  
245 North Water  
Wichita, KS 67202

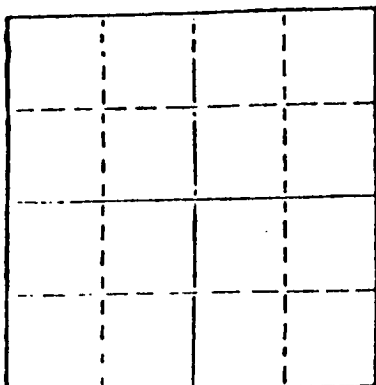

Locate well correctly on above  
Section Plat

Name of Conservation Agent who supervised plugging of this well Gilbert Scheck  
Producing formation \_\_\_\_\_ Depth to top \_\_\_\_\_ Bottom \_\_\_\_\_ Total Depth of Well 13,368'  
Show depth and thickness of all water, oil and gas formations.

Russell County. Sec. 27 Twp. 13 Rge. 15W E/W  
Location as "NE/CNW $\frac{1}{2}$ SW $\frac{1}{4}$ " or footage from lines \_\_\_\_\_  
SW NE NW  
Lease Owner V. Francis Weigel  
Lease Name Mills "B" Well No. 1  
Office Address Box 244, Gorham, Kansas 67640  
Character of Well (Completed as Oil, Gas or Dry Hole) \_\_\_\_\_  
Dry hole  
Date Well completed \_\_\_\_\_ 9-25 1983  
Application for plugging filed \_\_\_\_\_ 9-25 1983  
Application for plugging approved \_\_\_\_\_ 9-25 1983  
Plugging commenced \_\_\_\_\_ 9-25 1983  
Plugging completed \_\_\_\_\_ 9-25 1983  
Reason for abandonment of well or producing formation \_\_\_\_\_  
Dry hole  
If a producing well is abandoned, date of last production \_\_\_\_\_ 19

Was permission obtained from the Conservation Division or  
its agents before plugging was commenced? Yes

OIL, GAS OR WATER RECORDS

CASING RECORD

FORMATION	CONTENT	FROM	TO	SIZE	PUT IN	PULLED OUT
				8 5/8"	745'	Cmtd. w/325 sax.

Describe in detail the manner in which the well was plugged, indicating where the mud fluid  
was placed and the method or methods used in introducing it into the hold. If cement or other  
plugs were used, state the character of same and depth placed, from \_\_\_\_\_ feet to  
\_\_\_\_\_ feet for each plug set.

Spotted 20 sax cement @3,350' thru 4 $\frac{1}{2}$ " drill pipe  
Fill hole w/heavy mud  
Push bridge plug to 975'; spotted 20 sax cement on plug thru 4 $\frac{1}{2}$ " drill pipe  
Push bridge plug to 780'; spotted 40 sax cement on plug thru 4 $\frac{1}{2}$ " drill pipe  
Push bridge plug to 500'; spotted 80 sax cement on plug thru 4 $\frac{1}{2}$ " drill pipe  
Push bridge plug to 40' w/ $\frac{1}{2}$  sax hulls on plug  
Dump 10 sax cement on plug to cellar  
Dump 10 sax cement in rat hole  
Dump 10 sax cement in mouse hole

(If additional description is necessary, use BACK of this sheet)


Name of Plugging Contractor Shields Drilling Co., Inc.

STATE OF KANSAS COUNTY OF RUSSELL, ss. contractor  
R.L. Shields (~~employee of owner~~) or (~~owner or operator~~)  
of the above-described well, being first duly sworn on oath, says: That I have knowledge of  
the facts, statements, and matters herein contained and the log of the above-described well  
as filed and that the same are true and correct. So help me God.

(Signature) R.L. Shields  
Shields Bldg., Russell, Kansas 67665  
(Address)

SUBSCRIBED AND SWORN TO before me this 4th day of October, 1983

My commission expires

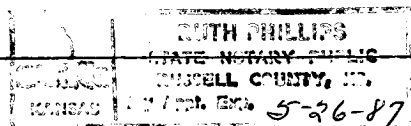

Ruth Phillips  
Notary Public.



# Shields


## WELL LOG

15-167-22222-00-00

Russell, Kansas

Operator: V. Francis Weigel  
Well: Mills "B" #1  
Commenced: September 17, 1983  
Completed: September 26, 1983  
Contractor: Shields Drilling Co., Inc.

Well Description: SW NE NW  
Sec. 27-13S-15W  
Russell Co., Kansas

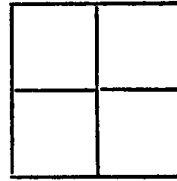

CASING RECORD		
Size	Run	Pulled
8 5/8"	745'	Cmtd. w/325 sax

Elevation: 1,922' KB

Treatment:

Production: D & A

Tops:

..... Figures Indicate Bottom of Formations .....

Surface soil, clay & post rock	40'
Shale & sand	520'
Sand	600'
Shale & sand	660'
Redbed	750'
Shale	800'
Redbed	973'
Anhydrite	1,011'
Shale & sand	1,369'
Shale & lime	2,828'
Lime	3,368' RTD

Notes