


STATE OF KANSAS
STATE CORPORATION COMMISSION

WELL PLUGGING RECORD

Give All Information Completely
Make Required Affidavit
Mail or Deliver Report to
Conservation Division
State Corporation Comm.
245 North Water
Wichita, KS 67202

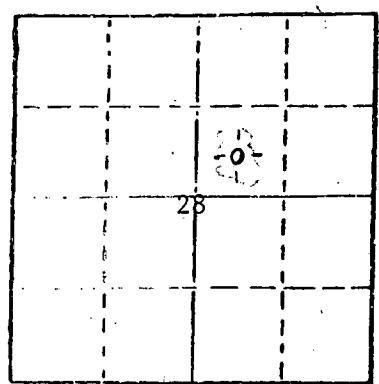

Locate well correctly on above
Section Plat

Harper County. Sec. 28 Twp. 34S Rge. 9W E/W
Location as "NE/CNW $\frac{1}{4}$ SW $\frac{1}{4}$ " or footage from lines
C SW NE
Lease Owner Presley Oil Company & Associated Petr. Consultant
Lease Name Crow Well No. 1
Office Address Suite 600 - One Main Place, Wichita, KS 67202
Character of Well (Completed as Oil, Gas or Dry Hole)
Dry hole
Date Well completed 8-16-81 19
Application for plugging filed 8-16-81 19
Application for plugging approved 8-16-81 19
Plugging commenced 6:15 p.m. 19
Plugging completed 7:30 p.m. 19
Reason for abandonment of well or producing formation
D & A
If a producing well is abandoned, date of last production
19

Was permission obtained from the Conservation Division or
its agents before plugging was commenced? yes
Name of Conservation Agent who supervised plugging of this well Morris Leslie

Producing formation None Depth to top X Bottom X Total Depth of Well 5160'
Show depth and thickness of all water, oil and gas formations.

OIL, GAS OR WATER RECORDS

CASING RECORD

FORMATION	CONTENT	FROM	TO	SIZE	PUT IN	PULLED OUT
				8 5/8"	240'	none

Describe in detail the manner in which the well was plugged, indicating where the mud fluid
was placed and the method or methods used in introducing it into the hold. If cement or other
plugs were used, state the character of same and depth placed, from feet to
feet for each plug set.

Run Hole Full of Mud. Set Plug 50 sacks 50-50 pozmix, 4% gel @ 240'
10 sacks at 40' in Bridge Plug
10 sacks in Rat Hole
5 sacks in Mouse Hole

(If additional description is necessary, use BACK of this sheet)


Name of Plugging Contractor State Corporation Commission of Kansas

STATE OF KANSAS COUNTY OF SEDGWICK, ss.
Ray Williams (employee of owner) or (owner or operator)
of the above-described well, being first duly sworn on oath, says: That I have knowledge of
the facts, statements, and matters herein contained and the log of the above-described well
as filed and that the same are true and correct. So help me God.

(Signature) Ray Williams
RAY WILLIAMS

SUBSCRIBED AND SWORN TO before me this 20th day of August, 1981

My commission expires

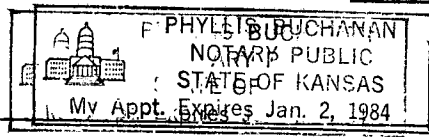

Phyllis Buchanan
PHYLLIS BUCHANAN
NOTARY PUBLIC
STATE OF KANSAS

RECEIVED
STATE CORPORATION COMMISSION

AUG 21 1981
CONSERVATION DIVISION
Wichita, Kansas