

STATE OF KANSAS
STATE CORPORATION COMMISSION
200 Colorado Derby Bldg.
Wichita, Kansas 67202

Form CP-4
RECEIVED 2-15-80
STATE CORPORATION COMMISSION

NOV 18 1982


WELL PLUGGING RECORD

CONSERVATION DIVISION
Wichita, Kansas

Give All Information Completely
Make Required Affidavit

COUNTY _____ Lane _____ SEC. 34 TWP. 16S RGE. 28W E/W
Location as in quarters or footage from lines:

C S/2 N/2 SW/4 Sec. 34-16S-28W

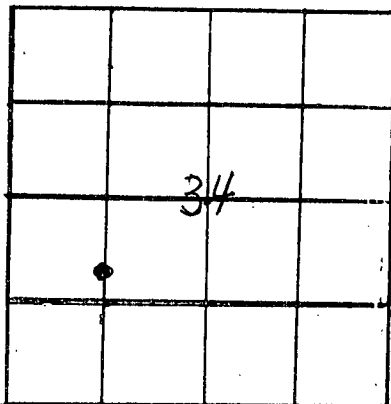

Locate Well
correctly on above
Section Platt.

Lease Owner Chief Drilling Co., Inc.

Lease Name Terwilliger "A" Well No. #1

Office Address 905 Century Plaza Wichita, Ks. 67202

Character of Well (Completed as Oil, Gas or Dry Hole): dry hole

Date Well Completed 11-13-82

Application for plugging filed 11-13-82

Plugging commenced 11-13-82

Plugging completed 11-13-82

Reason for abandonment of well or producing formation _____

Was permission obtained from the Conservation Division or it's
Agent's before plugging was commenced? yes

Name of Conservation Agent who supervised plugging of this well Steve Durrant

Producing formation _____ Depth to top _____ bottom T.D. 4613

Show depth and thickness of all water, oil and gas formations.

OIL, GAS OR WATER RECORDS

Casing Record

Formation	Content	From	To	Size	Put in	Pulled Out
surface	8 jts. 8 5/8" set @ 330'			20#		

Describe in detail the manner in which the well was plugged, indicating where the mud fluid was placed and the method or methods used in introducing it into the hold. If cement or other plugs were used, state the character of same and depth placed, from _____ feet to _____ feet for each plug set.

Plugged @ 1960 w/35 sks. 1140 w/70 sks.

450 w/40 sks. 10 sks. cement @ 40' 10 sks

in the rat hole, & 10 sks. in mouse hole Steve Durrant

State Plugger, Began @ 2:00 p.m. completed @ 5:30 p.m.

(If additional description is necessary, use BACK of this sheet)

Name of Plugging Contractor Warrior Drilling CO., Rig #2

STATE OF Kansas COUNTY OF Sedgwick, ss.

F.W. Shelton, Jr., (employee of owner) ~~owner~~ of the
above-described well, being first duly sworn on oath, says: That I have knowledge of the
facts, statements, and matters herein contained and the log of the above-described well as
filed and that the same are true and correct. So help me God.

(Signature)

F.W. Shelton, Jr., Vice Pres.
(Address)

SUBSCRIBED AND SWORN TO before me this 15th day of November, 19 82



MARTHA E. GUSTIN
NOTARY PUBLIC
STATE OF KANSAS
MY APPT. EXPIRES

Martha E. Gustin

Notary Public.

My Commission expires: 4-15-85

WELL LOG

CHIEF DRILLING CO., INC.

905 CENTURY PLAZA
WICHITA, KANSAS 67202TERWILLIGER "A" #1
C S/2 N/2 SW/4 SEC. 34-16S-28W
LANE COUNTY, KANSASCONTRACTOR: Warrior Drilling Co., Rig #2
CASING RECORD: 8 5/8" @ 330' w/185 sx. commonCOMMENCED: 11-02-82
COMPLETED: 11-13-82FORMATIONELEVATIONS:

Surface Clay	0	333	2756	GR.
Sand & Clay	333	815	2760	D.F.
Sand & Shale	815	2127	2763	K.B.
Shale	2127	2152		
Anhydrite	2152	2195		
Shale	2195	3170		
Shale & Lime	3170	3775		
Lime	3775	4173		
Lime & Shale	4173	4370		
Lime	4370	4613		
RTD	4613			

D & A

Plugged @ 1960 w/35 sks. 1140 w/70 sks. 450 w/40 sks.
10 sks. cement @ 40', 10 sks. in rat hole, & 10 sks.
in mouse hole, Steve Durrant State Plugger, Belpree
Began @ 2:00 p.m. completed @ 5:30 p.m. T.D. 4613 RTD

RECEIVED
STATE CORPORATION COMMISSION


NOV 18 1982

CONSERVATION DIVISION
Wichita, Kansas

STATE OF KANSAS, COUNTY OF SEDGWICK SS:

I hereby certify that the above is a true and correct copy of the
Drillers log of the well drilled in the C S/2 N/2 SW/4 Sec. 34-16S
-28W LANE COUNTY, KANSAS, to the best of my knowledge and belief.

CHIEF DRILLING CO., INC.

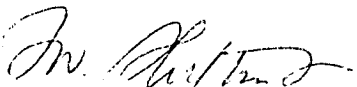

F.W. Shelton, Jr., Vice Pres.

Subscribed and sworn to before me this 15 day of November.

MARTHA E. GUST
NOTARY PUBLIC
STATE OF KANSAS
EXPIRES 7/1/83


Martha E. Gustin Notary Public