

WELL PLUGGING RECORD

Give All Information Completely  
Make Required Affidavit  
Mail or Deliver Report to:  
Conservation Division  
State Corporation Commission  
212 North Market, Insurance Bldg.  
Wichita, Kansas

Ellis County. Sec. 19 Twp. 13S Rge. 16 (E) W (W)

Location as "NE/CNWxSWx" or footage from lines. Approx. S/2 S/2 NW/4

Lease Owner & Operator: K & E Drilling, Inc.

Lease Name GEIST "E" Well No. 1

Office Address 719 Union Center Bldg., Wichita 2, Kansas

Character of Well (completed as Oil, Gas or Dry Hole) Dry Hole

Date well completed June 10, 19 60

Application for plugging filed (Verbal) June 11, 19 60

Application for plugging approved (Verbal) June 11, 19 60


Plugging commenced June 11, 19 60

Plugging completed June 11, 19 60

Reason for abandonment of well or producing formation Dry Hole

If a producing well is abandoned, date of last production 19

Was permission obtained from the Conservation Division or its agents before plugging was commenced? Yes

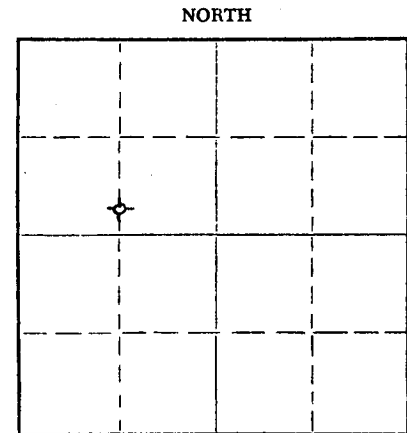

Locate well correctly on above Section Plat

Name of Conservation Agent who supervised plugging of this well Eldon Petty

Producing formation Depth to top Bottom Total Depth of Well 3551 Feet

Show depth and thickness of all water, oil and gas formations.

OIL, GAS OR WATER RECORDS

CASING RECORD

FORMATION	CONTENT	FROM	TO	SIZE	PUT IN	PULLED OUT
		0	238'	8-5/8"	238'	None

Describe in detail the manner in which the well was plugged, indicating where the mud fluid was placed and the method or methods used in introducing it into the hole. If cement or other plugs were used, state the character of same and depth placed, from feet to feet for each plug set.

First plug set at 480' with 20 sacks cement.  
Second plug set at 180' with 15 sacks cement.  
Third plug set at 40' with 10 sacks cement.  
Filled with mud to surface.

06-15-1960  
CONSERVATION  
Wichita, Kansas

(If additional description is necessary, use BACK of this sheet)

Name of Plugging Contractor Birmingham-Bartlett Drilling Co.  
Address 300 Kaufman Bldg., Wichita 2, Kansas

STATE OF KANSAS, COUNTY OF SEDGWICK, ss.  
Richard Hindery, partner of Birmingham-Bartlett Drilling Co., contractor

well, being first duly sworn on oath, says: That I have knowledge of the facts, statements, and matters herein contained and the log of the above-described well as filed and that the same are true and correct. So help me God. BIRMINGHAM-BARTLETT DRILLING CO.

(Signature) By Richard Hindery Partner  
300 Kaufman Bldg., Wichita 2, Kansas  
(Address)

SUBSCRIBED AND SWORN to before me this 13th day of June, 19 60.

My commission expires October 2, 1962.

Beverly Larson  
Notary Public.



GEIST "E" NO. 1 WELL

LOCATION: Approximately in the S/2 S/2 NW/4  
Section 19-13E-16W  
Ellis County, Kansas

OPERATOR: K & E Drilling, Inc.  
719 Union Center Building  
Wichita 2, Kansas

SURFACE CASING: 8-5/8" casing cemented at  
238' with 160 sacks cement.

OIL STRING: None set. Dry Hole. Plugging  
completed on 6-11-60.

CONTRACTOR: Birmingham-Bartlett Drilling Co.  
300 Kaufman Building  
Wichita 2, Kansas

SPUDDED: 6- 3-60  
COMPLETED: 6-10-60

LOG

(Figures indicate bottom of formation)

0 - 110	Rock and clay
540	Shale
900	Sand, shale, red bed
1136	Red bed
1180	Anhydrite
1575	Shale and shells
1880	Shale
2900	Lime and shale
2972	Shale
3030	Lime and shale
3223	Lime
3227	Haebner
3258	Lime and shale
3520	Lime
3551	Conglomerate
3551	Rotary total depth

COMMISSION  
JUN 15 1960  
06-15-1960  
CONSERVATION COMMISSION  
WICHITA, KANSAS

The undersigned, Richard Hindery, one of the partners of Birmingham-Bartlett Drilling Co., hereby certifies that the above is a true and correct log of the formations encountered in drilling the Geist "E" No. 1 Well as shown in the daily drilling reports.

BIRMINGHAM-BARTLETT DRILLING CO.

By Richard Hindery  
Richard Hindery, Partner

Subscribed and sworn to before me  
this 13th day of June, 1960.

Beverly Larson  
Beverly Larson, Notary Public

My commission expires October 2, 1962.