


Give All Information Completely  
Make Required Affidavit  
Mail or Deliver Report to:  
Conservation Division  
State Corporation Commission  
211 No. Broadway  
Wichita, Kansas

WELL PLUGGING RECORD

NORTH

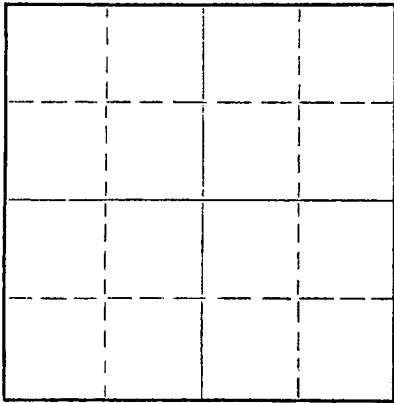

Locate well correctly on above  
Section Plat

Ellis County, Sec. 33 Twp. 13 Rge. 16 (E) W (W)  
Location as "NE/CNW/SW" or footage from lines NW SE NE  
Lease Owner Fred J. Haynes  
Lease Name Von Lintel Well No. 2  
Office Address Bldg. & Loan Bldg. Russell, Kansas  
Character of Well (completed as Oil, Gas or Dry Hole) D & A  
Date well completed 4-4-57 19  
Application for plugging filed 4-3-57 19  
Application for plugging approved 4-4-57 19  
Plugging commenced 4-4-57 19  
Plugging completed 4-5-57 19  
Reason for abandonment of well or producing formation

If a producing well is abandoned, date of last production 19  
Was permission obtained from the Conservation Division or its agents before plugging was commenced? Yes

Name of Conservation Agent who supervised plugging of this well Edon Petty Hays, Kansas  
Producing formation Depth to top Bottom Total Depth of Well 3478 Feet  
Show depth and thickness of all water, oil and gas formations.

OIL, GAS OR WATER RECORDS

CASING RECORD

FORMATION	CONTENT	FROM	TO	SIZE	PUT IN	PULLED OUT
				8 5/8"	206'	None

Describe in detail the manner in which the well was plugged, indicating where the mud fluid was placed and the method or methods used in introducing it into the hole. If cement or other plugs were used, state the character of same and depth placed, from 190 feet to 40 feet for each plug set.  
Hole filled with mud to 190' - set wooden plug at 190' and cemented with 20 sacks cement, filled with mud to 40', set wooden plug at 40' and cemented with 10 sacks cement.

(If additional description is necessary, use BACK of this sheet)

Name of Plugging Contractor Haynes Drilling Company  
Address Bldg. & Loan Bldg. Russell, Kansas

STATE OF Kansas, COUNTY OF Russell, ss.  
Fred J. Haynes (employee of owner) or (owner or operator) of the above-described well, being first duly sworn on oath, says: That I have knowledge of the facts, statements, and matters herein contained and the log of the above-described well as filed and that the same are true and correct. So help me God.

(Signature) *Fred J. Haynes*  
(Address)

SUBSCRIBED AND SWORN TO before me this 20th day of April, 19 57.

My commission expires January 17, 1961.

*Ralph L. Schulte*  
RECEIVED  
STATE CORPORATION COMMISSION  
Notary Public.

PLUGGING  
04-22-1957  
FILE SEC. 33 T. 13 R. 16W  
BOOK PAGE 4 LINE 41

15-051-04008 - 00-00

DRILLERS LOG

Von Lintel No. 2  
NW SE NE, 33-13-16  
Ellis County, Kansas

COMMENCED: 3-22-57  
COMPLETED: 4-5-57

I.P. - D & A

CASING: 206' 8 5/8"

FORMATION:

Clay & Post Rock	40
Post Rock & Shale	206
Shale, Shells, Sand	430
Sand & Iron	480
Shale & Sand	700
Red Bed & Shale	1050
Anhydrite	1099
Shale & Lime	1630
Salt	1700
Lime	2030
Lime & Shale	2216
Lime & Shale	2530
Lime	2910
Lime	3175
Lime	3454
Lime & Chert	3476
TD	3478

TOPS: Topeka 2931  
Heebner 3149  
Toronto 3170  
Lsg-KC 3198  
Cherty 3450  
Conglomerate

RECEIVED  
SEPT. 10. 1957  
CONSERVATION COMMISSION

APR 22 1957  
04-22-1957  
CONSERVATION DIVISION  
Wichita, Kansas

PLUGGING	
FILE SEC	33 T 13 R 16w
BOOK PAGE	4 LINE 41