


WELL PLUGGING RECORD

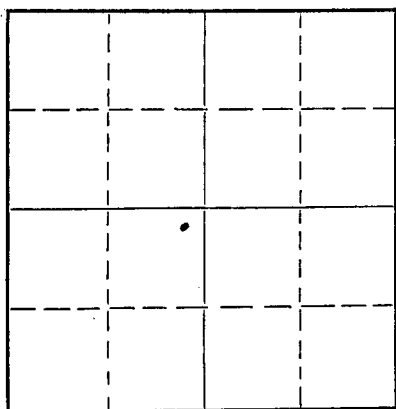

**Locate well correctly on above
Section Plat**

Ellis County. Sec. 11 Twp. 13 Rge. 16 ~~24~~ (W)
Location as "NE/CNW $\frac{1}{4}$ SW $\frac{1}{4}$ " or footage from lines NE $\frac{1}{4}$ NE $\frac{1}{4}$ SW $\frac{1}{4}$
Lease Owner Jackson - Lindsley Drilling Company
Lease Name Riedel Well No. 1
Office Address 1103 Baker Great Bend, Kansas
Character of Well (completed as Oil, Gas or Dry Hole) Dry Hole
Date well completed November 27 19.50
Application for plugging filed November 27 19.50
Application for plugging approved November 27 19.50
Plugging commenced November 27 19.50
Plugging completed November 27 19.50
Reason for abandonment of well or producing formation

If a producing well is abandoned, date of last production.....19.....
Was permission obtained from the Conservation Division or its agents before plugging was com-
menced?.....Yes.....

Name of Conservation Agent who supervised plugging of this well.....Eldon Petty.....
Producing formation.....None..... Depth to top..... Bottom..... Total Depth of Well.....3466.....Feet
Show depth and thickness of all water, oil and gas formations.

OIL, GAS OR WATER RECORDS

CASING RECORD

[illegible]

Describe in detail the manner in which the well was plugged, indicating where the mud fluid was placed and the method or methods used in introducing it into the hole. If cement or other plugs were used, state the character of same and depth placed, from.....feet tofeet for each plug set.

Filled with heavy mud to 275'

Set plug at 275!

Ran 20 sacks cement thru drill pipe

Filled with heavy mud to 40'

Set plug at 40!

Dumped 10 sacks cement and filled to bottom cellar.

(If additional description is necessary, use BACK of this sheet)

Correspondence regarding this well should be addressed to.....Jackson - Lindsley Drilling Company

Address 1103 Baker Great Bend, Kansas

STATE OF Kansas, COUNTY OF Barton, ss.

A. L. Jackson, partner in _____ (employee of owner) or (owner or operator) of the above-described well,
being first duly sworn on oath, says: That I have knowledge of the facts, statements, and matters herein contained and the log of the above-
described well as filed and that the same are true and correct. So help me God.

(Signature)

1103 Baker

Great Bend, Kansas
(Address)


SUBSCRIBED AND SWORN to before me this 5 day of December, 1950.

.....
Notary Public.

My commission expires.....May 9, 1951

22-7377-S

4-49-10M

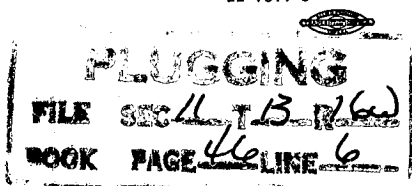

WELL LOG
Riedel # 1
C NE $\frac{1}{4}$ of NE $\frac{1}{4}$ of SW $\frac{1}{4}$
11-13-16

15-051-01194-00-00

Started November 14, 1950
Completed November 27, 1950
Days Worked 14 days drilling time
Total depth - 3466'

Anhydrite 1065'
Kansas City 3078'
Arbuckle 3436'

0-40	Surface and post rock
40-50	Sand and gravel
50-115	Shale
115-250	Shale, sand and shells
250-650	shale and shells
650-710	Sand
710-720	Red bed
720-980	Red bed, shale and shells
980-1065	Shale and shells
1065-1110	Anhydrite
1110-1215	Shale and salt
1215-1400	Shale and lime
1400-1550	Lime and shale
1550-1750	Shale and lime
1750-1765	Lime and shale
1765-1890	Lime
1890-2000	Lime and shale
2000-2250	Lime
2250-2387	Lime and shale
2387-2430	Shale
2430-2520	Lime and shale
2520-2610	Shale and lime
2610-2730	Shale and lime shells
2730-2780	Lime and shale
2780-2855	Shale and lime
2855-2940	Lime and shale
2940-3175	Lime
3175-3208	Shale and lime
3208-3340	Lime
3340-3385	Lime and shale
3385-3436	Lime
3436-3466	Arbuckle lime


3466

TOTAL ROTARY DEPTH

A F F I D A V I T

STATE OF Kansas, COUNTY OF Barton, SS

I A. L. Jackson of the Jackson-Lindsley Drlg. Company being first duly sworn on oath, state; That I have knowledge of the facts, statements and matters herein contained and that the same are true and correct.

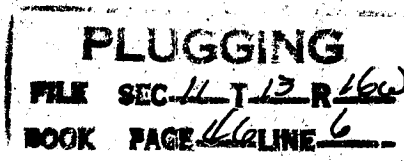

A. L. Jackson 12-07-1950
Partner

Subscribed and sworn to before me this 5 day of December, 1950.

My commission expires May, 9, 1951.

N. B. Brown
Notary Public