


OR
FORMATION PLUGGING RECORD

Strike out upper line when reporting plugging off formations.

Give All Information Completely
Make Required Affidavit
Mail or Deliver Report to:
Conservation Division
State Corporation Commission
800 Bitting Building
Wichita, Kansas

NORTH

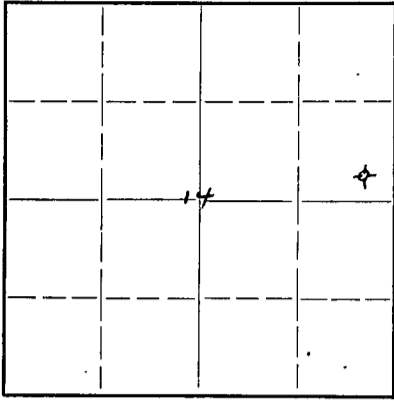

Locate well correctly on above Section Plat

Ellis County, Sec. 14 Twp. 13 Rge. (E) 16 (W)

Location as "NE 1/4 NW 1/4 SW 1/4" or footage from lines SE 1/4 SE 1/4 NE 1/4

Lease Owner Midstates Oil Corporation & Barnett Oil Company

Lease Name Dortland Well No. 1

Office Address 417 First Nat'l. Bank Bldg., Wichita, Kansas

Character of Well (completed as Oil, Gas or Dry Hole) Dry Hole

Date well completed March 16 1950

Application for plugging filed March 16 1950

Application for plugging approved March 16 1950

Plugging commenced March 17 1950

Plugging completed March 17 1950

Reason for abandonment of well or producing formation Dry Hole

If a producing well is abandoned, date of last production - 19

Was permission obtained from the Conservation Division or its agents before plugging was commenced? Yes

Name of Conservation Agent who supervised plugging of this well Eldon Petty, Hays, Kansas

Producing formation Arbuckle Depth to top 3396 Bottom 3450 Total Depth of Well 3450 Feet

Show depth and thickness of all water, oil and gas formations.

OIL, GAS OR WATER RECORDS

CASING RECORD

Formation	Content	From	To	Size	Put In	Pulled Out
Surface Casing		-0-	165'	8 5/8"	165'	None

Describe in detail the manner in which the well was plugged, indicating where the mud fluid was placed and the method or methods used in introducing it into the hold. If cement or other plugs were used, state the character of same and depth placed, from _____ feet to _____ feet for each plug set.

Filled hole with heavy mud to 160 feet. Set plug at 160 feet and filled with cement to 113 feet. Filled with heavy mud to 35 feet. Set plug at 35 feet and filled with cement to bottom of cellar.

(If additional description is necessary, use BACK of this sheet)

Correspondence regarding this well should be addressed to Barnett Oil Company

Address 417 First National Bank Building, Wichita, Kansas.

STATE OF Kansas, COUNTY OF Sedgwick, ss.

W. R. Hunter

(employee of owner) Barnett Oil Company

being first duly sworn on oath, says: That I have knowledge of the facts, statements, and matters herein contained and the log of the above-described well as filed and that the same are true and correct. So help me God.

(Signature)

W. R. Hunter

417 First National Bank Bldg., Wichita, Kansas
(Address)

SUBSCRIBED AND SWORN to before me this 23rd day of March 1950

Adelaide Olivier

Notary Public.

My commission expires May 12, 1951

PLUGGING
FILE SEC 14 T 13 R 16c
BOOK PAGE 44 LINE 6



03-29-1950

15-051-00981-00-00

MIDSTATES OIL CORPORATION AND BARNETT OIL COMPANY

LOG OF DORTLAND WELL NO. 1

SEC. 14, NE 1/4, SECTION 14-13S-16W, ELLIS COUNTY, KANSAS

Date Commenced: February 28, 1950

Date Completed: March 17, 1950

<u>Formation</u>	<u>From</u>	<u>To</u>	<u>Remarks</u>
Surface Clay and Shale	0	40	
Surface Clay	40	75	
Sand	75	95	
Shale and Shells	95	460	Set 6 5/8" Surface Pipe at 165 ft., cemented with 125 sacks.
Sand	460	510	
Sand and Shale	510	750	
Shale and Shells	750	1010	
Shale and Sand	1010	1040	
Lime	1040	1065	
Shale and Shells	1065	1525	
Salt and Shale	1525	1650	
Shale and Shells	1650	1900	
Lime and Shale	1900	2420	
Shale	2420	2670	
Shale and Lime	2670	2905	
Lime	2905	3051	
Lime and Shale	3051	3090	
Lime	3090	3450	
Total Depth		3450	Dry and Abandoned.

FILE SEC. 14, NE 1/4, 13S-16W
BOOK PAGE 199 LINE 1

03-29-1950