


WELL PLUGGING RECORD

Give All Information Completely  
Make Required Affidavit  
Mail or Deliver Report to:  
Conservation Division  
State Corporation Commission  
212 North Market, Insurance Bldg.  
Wichita, Kansas

NORTH

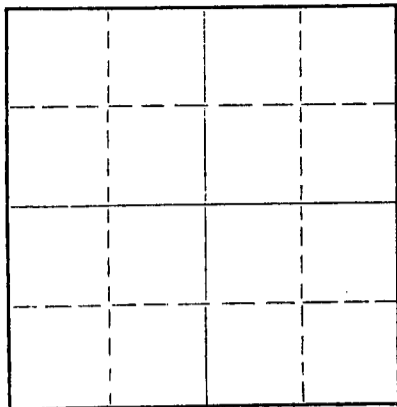

Locate well correctly on above Section Plat

Ellis County. Sec. 14 Twp. 13 Rge. 16 (E)W (W)  
Location as "NE/CNW/SW" or footage from lines SE/4 NE/4 NE? 4  
Lease Owner R. P. Nixon  
Lease Name Dortmund "B" Well No. 1  
Office Address Russell, Kansas  
Character of Well (completed as Oil, Gas or Dry Hole) Dry Hole  
Date well completed November 16 19 60  
Application for plugging filed November 16 19 60  
Application for plugging approved November 16 19 60  
Plugging commenced November 16 19 60  
Plugging completed November 16 19 60  
Reason for abandonment of well or producing formation Dry Hole

If a producing well is abandoned, date of last production 19  
Was permission obtained from the Conservation Division or its agents before plugging was commenced? Yes

Name of Conservation Agent who supervised plugging of this well  
Producing formation Depth to top Bottom Total Depth of Well 3,430 Feet  
Show depth and thickness of all water, oil and gas formations.

OIL, GAS OR WATER RECORDS

CASING RECORD

FORMATION	CONTENT	FROM	TO	SIZE	PUT IN	PULLED OUT
				8 5/8"	199'	Cmt'd w/140 sax

Describe in detail the manner in which the well was plugged, indicating where the mud fluid was placed and the method or methods used in introducing it into the hole. If cement or other plugs were used, state the character of same and depth placed, from feet to feet for each plug set.

Fill w/heavy mud to 500'  
Set bridging plug @ 500'  
Dump 20 sax cement on plug thru 4 1/2" drill pipe  
Fill w/heavy mud to 180'  
Set bridging plug @ 180'  
Dump 15 sax cement on plug thru 4 1/2" drill pipe  
Fill w/heavy mud to 40'  
Set bridging plug @ 40' w/ 1/2 sax hulls on plug  
Dump 10 sax cement on plug to cellar

RECEIVED  
STATE CORPORATION COMMISSION  
OCT 22 1962  
10-22-1962  
CONSERVATION DIVISION  
Wichita, Kansas

(If additional description is necessary, use BACK of this sheet)  
Name of Plugging Contractor Shields Drilling Company, Inc.  
Address Shields Bldg., Russell, Kansas

STATE OF Kansas COUNTY OF Russell, ss.  
R. P. Nixon (employee of owner) or (owner or operator) of the above-described well, being first duly sworn on oath, says: That I have knowledge of the facts, statements, and matters herein contained and the log of the above-described well as filed and that the same are true and correct. So help me God.

(Signature) *R. P. Nixon*  
754 East Wichita Ave., Russell, Kansas  
(Address)

SUBSCRIBED AND SWORN to before me this 5th day of October, 1962

*Ruth L Miller*

Notary Public.

My commission expires January 5, 1965





Shields


15-051-19334-00-00

Russell, Kansas

WELL LOG

Operator: R. P. Nixon  
 Well: Dortmund "B" #1  
 Commenced: November 8, 1960  
 Completed: November 16, 1960  
 Contractor: Shields Drilling Co., Inc.

Well Description: SE NE NE  
 Sec. 14-13S-16W  
 Ellis County, Kansas

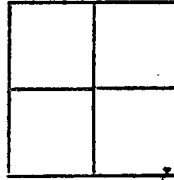

CASING RECORD

Size	Run	Pulled
8 5/8"	199'	Cmtd. w/140 sax

Elevation: 1961' RB  
 Treatment:

Production: D & A

Tops:	Formation	Elevation
	Topeka	2,840'
	Heebner	3,093'
	Toronto	3,112'
	Lansing-KC	3,143'
	Conglomerate	3,400'

..... Figures Indicate Bottom of Formations .....

Surface clay and shale	200'
Shale and shells	450'
Sand	550'
Shale and shells	1,030'
Shale	1,053'
Anhydrite	1,094'
Shale and shells	1,480'
Lime and Shale	3,050'
Lime	3,430' RTD

RECEIVED  
 STATE CORPORATION COMMISSION

OCT 22 1962  
 10-22-1962  
 CONSERVATION DIVISION  
 Wichita, Kansas

Notes

- DST #1 3,050 - 3107 Tool open 1 hr. Recovered 150' muddy water. IFP-80#, FFP-110#, BHP-915#/20 min.
- DST #2 3,148 - 3,175 Tool open 1 hr. Recovered 30' mud. IFP-0#, FFP-0#, BHP-570#/20 min.
- DST #3 3,231 - 3,243 Tool open 1 hr. Recovered 20' mud. IFP-0#, FFP-0#, BHP-0#/20 min.