


STATE OF KANSAS
STATE CORPORATION COMMISSION

Give All Information Completely
Make Required Affidavit
Mail or Deliver Report to:
Conservation Division
State Corporation Commission
212 No. Market
Wichita, Kansas
NORTH

WELL PLUGGING RECORD

Ellis County. Sec. 20 Twp. 11 Rge. 17 (W) (W)
Location as "NE/CNWxSWx" or footage from lines SW -NE- NW
Lease Owner Pattco Inc.
Lease Name Hadley D Well No. 8
Office Address 322 70W. Bldg. 70 W. 6th Ave. Denver, Colo.
Character of Well (completed as Oil, Gas or Dry Hole) Oil
Date well completed November 1964
Application for plugging filed September 18 1969
Application for plugging approved September 22 1969
Plugging commenced October 28 1969
Plugging completed November 6 1969
Reason for abandonment of well or producing formation Making all water

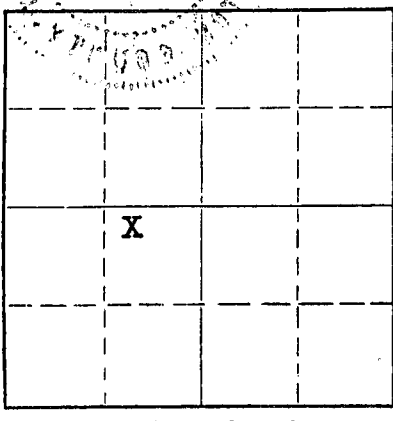

Locate well correctly on above
Section Plat

If a producing well is abandoned, date of last production October 1966
Was permission obtained from the Conservation Division or its agents before plugging was com-
menced? Yes

Name of Conservation Agent who supervised plugging of this well Leo Massey
Producing formation Arbuckle Depth to top 3429 Bottom 3451 Total Depth of Well 3452 Feet
Show depth and thickness of all water, oil and gas formations.

OIL, GAS OR WATER RECORDS

CASING RECORD

FORMATION	CONTENT	FROM	TO	SIZE	PUT IN	PULLED OUT
Arbuckle	Oil-Water	3431'	4way- jet	5 1/2'	3451'	633'±

Describe in detail the manner in which the well was plugged, indicating where the mud fluid was placed and the method or methods used in introducing it into the hole. If cement or other plugs were used, state the character of same and depth placed, from _____ feet to _____ feet for each plug set.

Plugged bottom off, from 3448' to 3400' with sand, 5 sacks cement
from 3400' to 3370'. Pulled 21 joints of 5 1/2", Pumped 4 sacks hulls, 20
sacks gel mud and 100 sacks cement in 8 5/8" casing to plug well. Capped
8 5/8" casing with 3 sacks of cement.

RECEIVED
STATE CORPORATION COMMISSION
NOV 18 1969
CONSERVATION DIVISION
Wichita, Kansas

(If additional description is necessary, use BACK of this sheet)

Name of Plugging Contractor Glenn and Smith
Address Ellinwood, Kansas

STATE OF Kansas, COUNTY OF Barton, ss.
Delbert Reed (employee of owner) or (owner or operator) of the above-described well, being first duly sworn on oath, says: That I have knowledge of the facts, statements, and matters herein contained and the log of the above-described well as filed and that the same are true and correct. So help me God.

(Signature) Pattco Inc by Delbert Reed

(Address) Barbara Nuss
Subscribed and sworn to before me this 17th day of November, 1969



Notary Public.