


STATE OF KANSAS
STATE CORPORATION COMMISSION

Give All Information Completely
Make Required Affidavit
Mail or Deliver Report to:
Conservation Division
State Corporation Commission
211 No. Broadway
Wichita, Kansas

WELL PLUGGING RECORD

Ellis County, Sec. 20 Twp. 11S Rge. 17W (E) (W)

Location as "NE/CNW/SW" or footage from lines SW/4 SW/4 SW/4
Lease Owner Walters Drilling Co., et al
Lease Name Hadley "A" Well No. 1
Office Address 510 Orpheum Building, Wichita 2, Kansas
Character of Well (completed as Oil, Gas or Dry Hole) Oil
Date well completed March 8, 19 54
Application for plugging filed (verbal) July 16, 19 56
Application for plugging approved (verbal) July 16, 19 56
Plugging commenced July 23, 19 56
Plugging completed July 26, 19 56
Reason for abandonment of well or producing formation Dakota water broke in

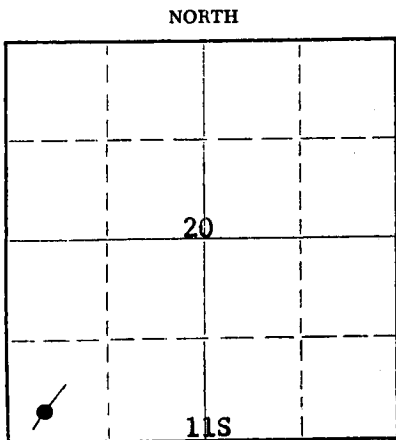

Locate well correctly on above Section Plat

If a producing well is abandoned, date of last production February 3, 19 56
Was permission obtained from the Conservation Division or its agents before plugging was commenced? Yes

Name of Conservation Agent who supervised plugging of this well Eldon Petty
Producing formation Arbuckle Depth to top 3474 Bottom 3510 Total Depth of Well 3510 Feet
Show depth and thickness of all water, oil and gas formations.

OIL, GAS OR WATER RECORDS

CASING RECORD

FORMATION	CONTENT	FROM	TO	SIZE	PUT IN	PULLED OUT
None	None	0	171'	8 5/8"	175'	None
Arbuckle	oil	3474	3510'	5 1/2"	3531'	2782.85'

Describe in detail the manner in which the well was plugged, indicating where the mud fluid was placed and the method or methods used in introducing it into the hole. If cement or other plugs were used, state the character of same and depth placed, from 3510 feet to surface feet for each plug set.

Hole filled with sand from 3510 to 3480 ft; four sacks of cement placed in hole with dump bailer to form cement plug from 3480 to 3448 ft; thereafter 5 in. casing pulled and Halliburton pump trucks pumped in 30 sacks of drilling mud and 80 sacks of cement through 8 5/8" casing. Plugging complete.

(If additional description is necessary, use BACK of this sheet)

Name of Plugging Contractor Barnes and Sons Pipe Pulling Co.,
Address Russell, Kansas

STATE OF KANSAS, COUNTY OF SEDGWICK, ss.

Robert F. Walters (owner or operator) of the above-described well, being first duly sworn on oath, says: That I have knowledge of the facts, statements, and matters herein contained and the log of the above-described well as filed and that the same are true and correct. So help me God.

(Signature) Robert F. Walters
510 Orpheum Building, Wichita 2, Kansas
(Address)

SUBSCRIBED AND SWORN to before me this 6th day of August, 19 56

Pauline Hudickera
Notary Public.

My commission expires March 10, 1960

PLUGGING
FILE SEC 20 T 11 R 17W
BOOK PAGE 85 LINE 31

AUG 9 1956
CONSERVATION DIVISION
Wichita, Kansas

HADLEY "A" NO. 1

Location:	SW SW SW Sec. 20-11S-17W, Ellis County, Kansas	Date Spudded: 2-24-54
Operator:	Walters Drilling Co., Inc.	Rotary Completion: 3-8-54
Contractor:	Walters Drilling Co., Inc.	Elevation: 1965 Gr 1968 DF 1970 KB
Surface Casing:	8 5/8" set at 171' with 100 sacks cement and 1 sack Cal. Chloride	
Oil String:	5 1/2" set at 3510' with 100 sacks cement	

L O G

(Figures indicate bottom of formation)

Surface	0 to 171
Shale and Shells	515
Sand and Shells	610
Sand and Lime	660
Shale	720
Sand and Shale	865
Shale	1212
Anhydrite	1250
Shells and Shale	1430
Shale and Lime Shells	1735
Shale and Lime	1864
Lime	1987
Lime and Shale	2528
Shale and Shells	2620
Shale	2823
Shale and Lime	2898
Lime and Shale	2918
Lime	2990
Lime and Shale	3050
Lime	3099
Lime and Shale	3180
Lime	3464
Lime and Shale	3499
Lime	3510
Total Depth (Rotary)	3510

The undersigned, Robert F. Walters, hereby certifies that the above log is a true and correct log of the formations encountered in drilling the above noted well as reflected by the Daily Drilling Reports.

WALTERS DRILLING CO., INC.

By Robert F. Walters

Subscribed and sworn to before me
this 12th day of March, 1954.

Pauline Neudickson
Notary Public

My commission expires: March 1957

RECEIVED
STATE CORPORATION COMMISSION
AUG 1954

08-09-54

PLUGGING
FILE SEC 20 T 11 R 17W
BOOK PAGE 45 LINE 31