

STATE OF KANSAS  
STATE CORPORATION COMMISSION

WELL PLUGGING RECORD


OR

FORMATION PLUGGING RECORD

Strike out upper line  
when reporting plugging  
of formations.

Give All Information Completely  
Make Required Affidavit  
Mail or Deliver Report to:  
Conservation Division  
State Corporation Commission  
800 Bitting Building  
Wichita, Kansas

NORTH

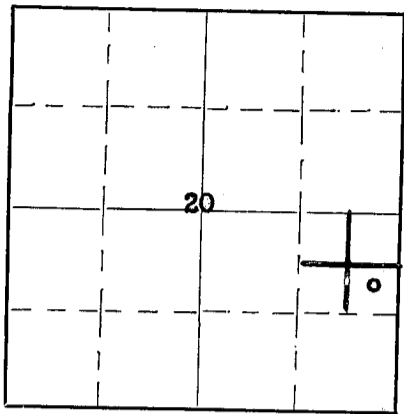

Locate well correctly on above  
Section Plat

Ellis County. Sec. 20 Twp 11S Rge. 17 (W)  
Location as "NE 1/4 NW 1/4 SW 1/4" or footage from lines. E/2, SE/4  
Lease Owner. The Winkler-Koch Engineering Company  
Lease Name. Hadley B. Well No. 1  
Office Address. 335 West Lewis St., Wichita, Kansas  
Character of Well (completed as Oil, Gas or Dry Hole). Dry Hole  
Date, well completed. April 14 1940  
Application for plugging filed April 14 1940  
Application for plugging approved April 15 1940  
Plugging Commenced April 14 1940  
Plugging Completed April 14 1940  
Reason for abandonment of well ~~producing formation~~ dry hole

If a producing well is abandoned, date of last production. 193...  
Was permission obtained from the Conservation Division or its agents before plugging was commenced? Yes

Name of Conservation Agent who supervised plugging of this well. Mr. C. T. Alexander  
Producing formation. Arbuckle Lime Depth to top. 3,677 Bottom. 3,692 Total Depth of Well. 3,692 Feet  
Show depth and thickness of all water, oil and gas formations.

OIL, GAS OR WATER RECORDS


CASING RECORD

Formation	Content	From	To	Size	Put In	Pulled Out
See attached log				15 1/2 "	48' 7"	None
				7 "	3620' 7"	3,000'

Describe in detail the manner in which the well was plugged, indicating where the mud fluid was placed and the method or methods used in introducing it into the hole. If cement or other plugs were used, state the character of same and depth placed, from 3,692' feet to 3,677' feet for each plug set.

Cement plug placed from 3692' to 3677' at bottom of hole in 7" casing, the hole filled with mud to 300'. Hole bridged at 300' with a 15' cement plug set on bridge. Mud to 6' of bottom of cellar. Cement to top of surface pipe at bottom of cellar.

PLUGGING  
FILE SEC. 20 T. 11 R. 17 W  
BOOK PAGE 99 LINE 22

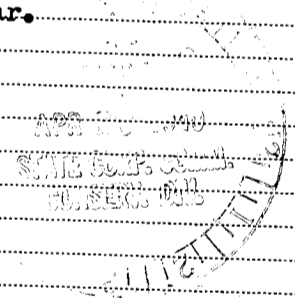

(If additional description is necessary, use BACK of this sheet)

Correspondence regarding this well should be addressed to The Winkler-Koch Engineering Company  
Address. 335 West Lewis St., Wichita, Kansas

STATE OF Kansas, COUNTY OF Sedgwick, ss.  
A. T. Watson (employee of owner) or ~~owner or operator~~


being first duly sworn on oath, says: That I have knowledge of the facts, statements, and matters herein contained and the log of the above-described well as filed and that the same are true and correct. So help me God:

(Signature) A. T. Watson

335 West Lewis St., Wichita, Kansas (Address)

SUBSCRIBED AND SWORN to before me this 26 day of April, 1940

My commission expires July 26, 1943

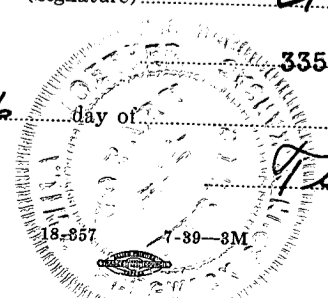

Notary Public.

WELL LOG

Winkler & Koch Hadley 1-B Well, drilled in Ellis County, Kansas,  
 Section 20-11-17, completed April 3, 1940.

<u>Formation</u>	<u>From</u>	<u>To</u>	
Surface Lime	0	40	
Shale and Shells	40	270	
Shale and sand	270	485	
Shale and shells	485	725	
Pyrite	725	730	
Pyrite and shale	730	750	
Shale and shells	750	830	
Sand	830	934	
Red Beds	934	1005	
Shale and Pyrite	1005	1114	
Red Beds and Shells	1114	1290	
Anhydrite	1290	1340	
Shale and shells	1340	1890	
Lime	1890	2025	
Anhydrite	2025	2063	
Shale and shells	2063	2090	
Broken lime	2090	2160	
Lime	2160	2438	
Broken lime	2438	2510	
Lime and shale streaks	2510	2560	
Lime and shale	2560	2620	
Lime	2620	2660	
Shale and shells	2660	2730	
Broken lime	2730	2785	
Shale	2785	2835	
Lime	2835	2865	
Shale	2865	2880	
Sandy lime	2880	2900	
Lime	2900	2960	
Shale and shells	2960	3030	
Lime	3030	3080	
Lime	3080	3135	
Topeka Lime	3135	3180	
Lime	3180	3325	
Shale	3325	3335	
Lime	3335	3362	
Kansas City Lime	3362	3403	
Lime	3403	3550	
Lime and shale	3550	3572	
Lime	3572	3587	
Green shale	3587	3599	
Sand and lime	3599	3617	
			Total Depth
			Rotary

We hereby certify the above to be a true and correct log of the  
 above described well.

MITCHELL DRILLING COMPANY

By

Cable Tool Log.

20 11 17W  
 99 22

Sandy Green Shale & Chert	3611	3628	
" " " "	3628	3633	
Green Shale	3633	3642	
Lime & Green Shale	3642	3650	
Green Shale - Chert & Lime	3650	3657	
Green Shale & Chert	3657	3671	
Chert.	3671	3686	
Lime	3686	3690	Total Depth