


Give All Information Completely
Make Required Affidavit
Mail or Deliver Report to:
Conservation Division
State Corporation Commission
921 No. Broadway
Wichita, Kansas

WELL PLUGGING RECORD

Ellis County, Sec. 36 Twp. 13S Rge. (E) 16W (W)

Location as "NE/CNW/SW" or footage from lines SE 1/4 NW 1/4 NE 1/4
Lease Owner Birmingham-Bartlett Drilling Co.
Lease Name Nowak Well No. 2
Office Address 300 Kaufman Bldg., Wichita, Kansas, 67202
Character of Well (completed as Oil, Gas or Dry Hole) Oil Well
Date well completed April 23 19 64
Application for plugging filed January 28, 19 65
Application for plugging approved January 29, 19 65
Plugging commenced February 17, 19 65
Plugging completed February 19, 19 65
Reason for abandonment of well or producing formation Production depleted to a point where well was uneconomical to operate.
If a producing well is abandoned, date of last production January 1, 19 65
Was permission obtained from the Conservation Division or its agents before plugging was commenced? Yes

NORTH

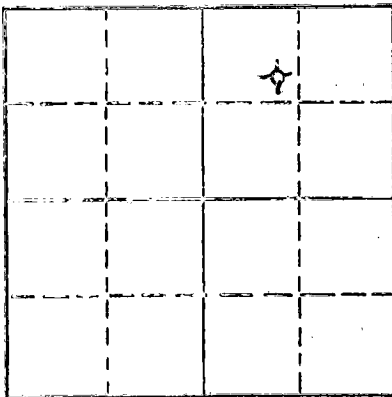

Locate well correctly on above Section Plot

Name of Conservation Agent who supervised plugging of this well Eldon Petty
Producing formation Conglomerate Sand Depth to top 3356 Bottom Total Depth of Well 3390 Feet
Show depth and thickness of all water, oil and gas formations.

OIL, GAS OR WATER RECORDS

CASING RECORD

FORMATION	CONTENT	FROM	TO	SIZE	PUT IN	PULLED OUT
			0	238'	238'	None
			0	3384'	3384'	2660'

Describe in detail the manner in which the well was plugged, indicating where the mud fluid was placed and the method or methods used in introducing it into the hole. If cement or other plugs were used, state the character of same and depth placed, from feet to feet for each plug set.

Plugged back with sand from 3377' to 3350'. Mixed and dumped 4 sx. of cement from 3350' to 3316' with dump bailer. Pulled casing to 450'. Mixed and ~~plugged~~ circulated 20 sx. of gel mud. Mixed and pumped in 20 sx. of cement from 450' to 390'. Pulled casing to 210'. Mixed and pumped in 20 sx. of cement from 210' to 150'. Pulled rest of the casing. Bailed off gel to 40'. Set 10' rock bridge from 40' to 30'. Mixed and dumped 10 sx. of cement from 30' to base of the cellar.

RECEIVED
STATE CORPORATION COMMISSION

MAR 18 1965
03-16-1965
CONSERVATION DIVISION
WICHITA, KANSAS

(If additional description is necessary, use BACK of this sheet)

Name of Plugging Contractor Ace Pipe Pulling Co.
Address Box 304 Great Bend, Kan.

STATE OF KANSAS, COUNTY OF SEDGWICK
Chas. H. Keevert, Prod. Supt. of Birmingham-Bartlett Drilling Co.,
(employee of owner) or (owner or operator) of the above-described well, being first duly sworn on oath, says: That I have knowledge of the facts, statements, and matters herein contained and the log of the above-described well as filed and that the same are true and correct. So help me God.

(Signature) Chas. H. Keevert
Wilson Road, Route 1, Hutchinson, Kansas
(Address)

SUBSCRIBED AND SWORN to before me this 15th day of March 19 65.

Vivian F. Yinger
Vivian F. Yinger Notary Public.

My commission expires November 29, 1966.

15-051-02656-00-00

NOWAK NO. 2 WELL

LOCATION: SE $\frac{1}{4}$ NW $\frac{1}{4}$ NE $\frac{1}{4}$ Sec. 36-135-16W
Ellis County, Kansas

SPUDED: 4-12-64

COMPLETED: 4-19-64

OWNER, OPERATOR
and CONTRACTOR: Birmingham-Bartlett Drilling Co.
300 Kaufman Building
Wichita, Kansas, 67202

SURFACE CASING: 8-5/8" casing cemented at 237 $\frac{1}{2}$
with 160 sacks cement.

OIL STRINGS: 110 Jts. 5 $\frac{1}{2}$ " OD 1 $\frac{1}{2}$ " 8 rd. J-55 R-2
Sols. set at 338 $\frac{1}{2}$ " with 125 sacks cement.

LOG

(Figures indicate bottom of formation)

0 -	100	Clay & Sand
	238	Shale
	530	Shale & Shells
	640	Sand
	987	Shale & Red Bed
	1027	Anhydrite
	1680	Shale & Shells
	2225	Lime & Shale
	2415	Shale & Lime Streaks
	2555	Shale & Shells
	3012	Lime & Shale
	3282	Lime
	3330	Lime & Shale
	3385	Lime
	3385	Rotary total depth

01-29 1965

The undersigned, Richard Hindery, one of the partners of Birmingham-Bartlett Drilling Co., hereby certifies that the above is a true and correct log of the Nowak #2 Well as shown in the daily drilling reports.

BIRMINGHAM-BARTLETT DRILLING CO.

By Richard Hindery
Richard Hindery, Partner

Subscribed and sworn to
before me this 15th day of May, 1964

Vivian F. Yinger
Vivian F. Yinger, Notary Public

My commission expires Nov. 29, 1966.