

STATE OF KANSAS  
STATE CORPORATION COMMISSION


15-051-00316-00-00

WELL PLUGGING RECORD

Give All Information Completely  
Make Required Affidavit  
Mail or Deliver Report to:  
Conservation Division  
State Corporation Commission  
311 No. Broadway  
Wichita, Kansas

Ellis County, Sec. 36 Twp. 13 Rge. 16 (E) (W) x

NORTH

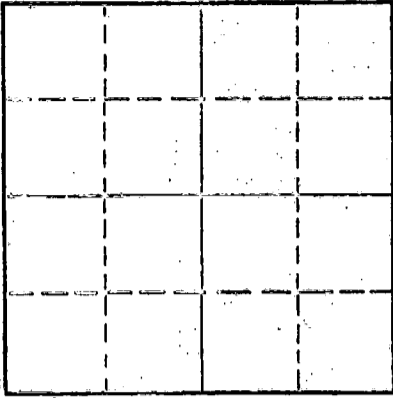

Locate well correctly on above  
Section Plat

Location as "NE/CNW/SW" or footage from lines 117/0  
Lease Owner Woodman & Tannitti Drilling Co.  
Lease Name Baumgardt Well No. 1  
Office Address P. O. Box 387, Moisington, Kans.  
Character of Well (completed as Oil, Gas or Dry Hole) dry  
Date well completed 12-18-59 19  
Application for plugging filed 12-18-59 19  
Application for plugging approved 12-18-59 19  
Plugging commenced 12-18-59 19  
Plugging completed 12-18-59 19  
Reason for abandonment of well or producing formation dry

If a producing well is abandoned, date of last production 19  
Was permission obtained from the Conservation Division or its agents before plugging was commenced? yes

Name of Conservation Agent who supervised plugging of this well Edon Petty  
Producing formation \_\_\_\_\_ Depth to top \_\_\_\_\_ Bottom \_\_\_\_\_ Total Depth of Well 3900 Feet  
Show depth and thickness of all water, oil and gas formations.

OIL, GAS OR WATER RECORDS

CASING RECORD

FORMATION	CONTENT	FROM	TO	SIZE	PUT IN	PULLED OUT
				8 5/8"	235'	

Describe in detail the manner in which the well was plugged, indicating where the mud fluid was placed and the method or methods used in introducing it into the hole. If cement or other plugs were used, state the character of same and depth placed, from \_\_\_\_\_ feet to \_\_\_\_\_ feet for each plug set.

Bottom Plug 2901 with 25 sacks.  
Top Plug 401 with 10 sacks.

REGISTRY  
STATE CORPORATION COMMISSION

DEC 23 1959

CONSERVATION DIVISION

12-23-1959

(If additional description is necessary, use BACK of this sheet)

Name of Plugging Contractor Woodman & Tannitti Drilling Co.  
Address P. O. Box 387, Moisington, Kans.

STATE OF Kansas, COUNTY OF Sedgewick, ss.  
K. T. Woodman (employee of owner) or (owner or operator) of the above-described well, being first duly sworn on oath, says: That I have knowledge of the facts, statements, and matters herein contained and the log of the above-described well as filed and that the same are true and correct. So help me God.

(Signature) K. T. Woodman  
K. T. Woodman  
714 Union Natl. Bldg. Wichita, Kans. (Address)

SUBSCRIBED AND SWORN TO before me this 22nd day of December, 1959  
Edna J. Buschow

My commission expires Feb. 16, 1961 Notary Public.



COMPANY: Woodman & Iannitti Oil Company  
714 Union National Building  
Wichita, Kansas

Rotary Drilling Commenced: December 9, 1959  
Rotary Drilling Completed: December 18, 1959

LOCATION: No. 1 Brungardt  
NW corner of Sec. 36-13S-16W  
Ellis County, Kansas

CONTRACTOR: Shelley-Miller Drilling Company  
205 Miller Building  
Wichita, Kansas

CASING RECORD: 5 1/2" 28# casing set @ 235 feet, cemented with 175 sacks.

L O G  
(Measurements from top of Rotary Bushing to bottom of formation)

Surface Shale	15
Iron & Sand	185
Shale & Shells	974
Anhydrite	1,020
Shale & Shells	1,740
Lime & Shale	1,845
Lime	2,075
Lime & Shale	2,185
Lime	2,255
Lime & Shale	2,525
Shale & Lime	2,710
Lime & Shale	2,845
Lime	3,390 Rotary T.D.

The undersigned, Richard A. Shelley, Partner of Shelley-Miller Drilling Company, hereby certifies in behalf of said Company, that the above log is a true and correct log of the formation encountered in drilling the above well as reflected by the Daily Drilling Reports.

SHELLEY-MILLER DRILLING COMPANY

By Richard A. Shelley

STATE OF KANSAS )  
COUNTY OF SEDGWICK ) SS

BE IT REMEMBERED, that on this 21st day of December, 1959, before me, the undersigned, a Notary Public, duly commissioned in and for the county and state aforesaid, came Richard A. Shelley, Partner, and known to me to be the same person who executed the foregoing instrument of writing in behalf of Shelley-Miller Drilling Company, as a Partner of said company, and he duly acknowledged the execution of the same for himself and for said company.

IN WITNESS WHEREOF, I have hereunto set my hand and official seal on the day and year last above written.

Notary Public

My Commission Expires:  
March 24, 1960