


WELL PLUGGING RECORD

Give All Information Completely
Make Required Affidavit
Mail or Deliver Report to:
Conservation Division
State Corporation Commission
800 Bitting Building
Wichita, Kansas

Ellis County, Sec. 35 Twp. 13 Rgs. 16 (X) (W)
Location as "NE/CNW/SE/SW" or footage from lines: NW NW SW
Lease Owner: Fred J. Haynes
Lease Name: Kippes Well No. 1
Office Address: Russell, Kansas
Character of Well (completed as Oil, Gas or Dry Hole): Dry Hole
Date well completed: April 26, 19 54
Application for plugging filed: April 26, 19 54
Application for plugging approved: April 26, 19 54
Plugging commenced: April 26, 19 54
Plugging completed: April 26, 19 54
Reason for abandonment of well or producing formation: Dry Hole

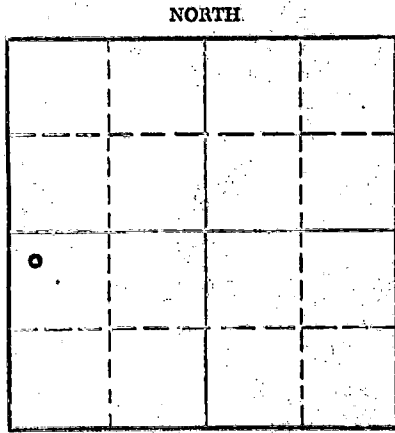

Locate well correctly on above Section Plat

If a producing well is abandoned, date of last production: 19
Was permission obtained from the Conservation Division or its agents before plugging was commenced? Yes

Name of Conservation Agent who supervised plugging of this well: Eldon Petty
Producing formation: Depth to top: Bottom: Total Depth of Well: 3512 Feet
Show depth and thickness of all water, oil and gas formations.

OIL, GAS OR WATER RECORDS

CASING RECORD

FORMATION	CONTENT	FROM	TO	SIZE	PUT IN	PULLED OUT
				8 5/8"	257'	cemented

Describe in detail the manner in which the well was plugged, indicating where the mud fluid was placed and the method or methods used in introducing it into the hole. If cement or other plugs were used, state the character of same and depth placed, from feet to feet for each plug set.

Heavy Mud at 240'
1/2 sack hulls and 8 5/8" bridging plug at 240'
15 sacks cement through 4 1/2" drill pipe at 240'
Heavy mud to 40'
1/2 sack hulls and 8 5/8" bridging plug at 40'
10 sacks cement on plug to surface

05-03-1954

(If additional description is necessary, use BACK of this sheet)
Name of Plugging Contractor: Shields Drilling Co., Inc.
Address: Box 248 - Russell, Kansas


STATE OF Kansas, COUNTY OF Russell, ss.
H. E. Reiss (employee of owner) or (owner or operator) of the above-described well, being first duly sworn on oath, says: That I have knowledge of the facts, statements, and matters herein contained and the log of the above-described well as filed and that the same are true and correct. So help me God.

(Signature) H. E. Reiss
Box 248 - Russell, Kansas (Address)

SUBSCRIBED AND SWORN TO before me this 28th day of April, 19 54

Jack P. Beeman
Notary Public.

My commission expires December 18, 1957

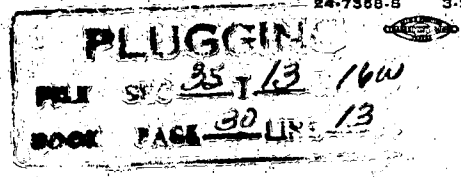

WELL LOG

Fred J. Haynes
KIPPES #1

NW NW SW
Sec. 35, Twp 13S, Rge 16W
Ellis County, Kansas

Total Depth: 3512'
Commenced: April 12, 1954
Completed: April 26, 1954
Drilled by Shields Drilling Co., Inc.

CASING RECORD

8 5/8" 260' Cmtd. w/ 125 sax

Elevation: 1936 R.L.
Production: D & A

-----Figures Indicate Bottom of Formation-----

Sand	20
Shale	257
Shale & Sand	545
Sand	670
Red Bed & Shale	785
Shale & Red Bed	1000
Red Bed & Shale	1037
Anhydrite	1070
Shale	1365
Shale & Salt	1400
Shale	1745
Lime & Shale	1790
Lime	1855
Lime & Shale	2077
Shale & Lime	2180
Lime & Shale	2490
Shale	2725
Shale & Lime	2999
Lime & Shale	3035
Lime	3078
Lime & Shale	3160
Lime	3200
Lime & Shale	3279
Lime	3315
Lime & Shale	3391
Lime	3409
Shale	3426
Lime & Shale	3454
Conglomerate	3497
Arbuckle	3512 T.D.

TOPS

Drillers Anhydrite	1037
Topeka Lime	2903
Heebner Shale	3125
Toronto Lime	3144
Lansing K.C.	3171
Base/ K.C.	3409
Conglomerate	3429
Arbuckle	3487
Rotary T.D.	3512

NOTES

DST #1 - 3100 - 3204 Open 1 hour, weak steady blow, received
15' GCM, 75' Salt Water, BHP 700#, IFP 0#, IFR 45#