


Give All Information Completely
Make Required Affidavit
Mail or Deliver Report to:
Conservation Division
State Corporation Commission
800 Bittling Building
Wichita, Kansas

15-051-00639-00-00

WELL PLUGGING RECORD

NORTH

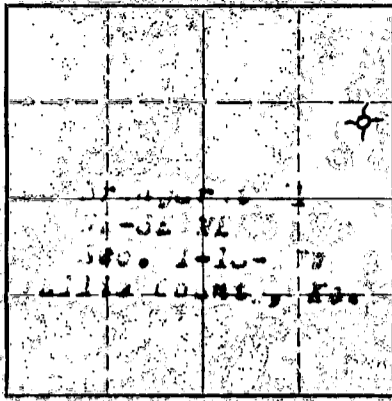

Locate well correctly on above Section Plat

County Ellis Sec. 1 Twp. 13S Rge. 17W (E) W (W)
Location as "NE/CNW $\frac{1}{4}$ SW $\frac{1}{4}$ " or footage from lines NE-SW-NE
Lease Owner W. J. Coppinger
Lease Name Brungardt Well No. #1
Office Address Union National Bank Building, Wichita, Kansas
Character of Well (completed as Oil, Gas or Dry Hole) Dry Hole
Date well completed 11-8 1951
Application for plugging filed 11-7 1951
Application for plugging approved 11-7 1951
Plugging commenced 11-7 12:00 P.M. 1951
Plugging completed 11-8 8:00 A.M. 1951
Reason for abandonment of well or producing formation Dry Hole

If a producing well is abandoned, date of last production 10
Was permission obtained from the Conservation Division or its agents before plugging was commenced? Yes Verbal

Name of Conservation Agent who supervised plugging of this well Eldon Petty
Producing formation Depth to top Bottom Total Depth of Well 3615 Feet
Show depth and thickness of all water, oil and gas formations.

OIL, GAS OR WATER RECORDS

CASING RECORD

Formation	Content	From	To	Size	Put In	Pulled Out
<u>Post rock, shale</u>		<u>0</u>	<u>216'</u>	<u>8 5/8"</u>	<u>216'</u>	<u>none</u>
<u>Lansing (K.C.)</u>		<u>3293'</u>	<u>3553'</u>		<u>Dry</u>	<u>Dry</u>
<u>Arbuckle</u>		<u>3564'</u>	<u>3615'</u>		<u>Dry</u>	<u>Dry</u>
<u>Total Depth</u>	<u>3615'</u>					

Describe in detail the manner in which the well was plugged, indicating where the mud fluid was placed and the method or methods used in introducing it into the hole. If cement or other plugs were used, state the character of same and depth placed, from feet to feet for each plug set.

Stirred pits, filled hole with heavy mud. Set bottom wood plug at 210 feet. Ran 1/2 Halls and 15 sacks cement on bottom wood plug. Filled with heavy mud to 40 feet. Set wood plug at 40 feet. Ran 1/2 Sack of Halls and 10 sacks cement filling to bottom of cellar.

(If additional description is necessary, use BACK of this sheet)

11-13-1951

Name of Plugging Contractor Strain Drilling Company
Address Box 188, Hays, Kansas

STATE OF Kansas COUNTY OF Ellis, ss.
T. C. Strain (employee of owner) or (owner or operator) of the above-described well,


being first duly sworn on oath, says: That I have knowledge of the facts, statements, and matters herein contained and the log of the above-described well as filed and that the same are true and correct. So help me God.

(Signature) T. C. Strain

Box 188, Hays, Kansas (Address)

SUBSCRIBED AND SWORN to before me this 9 day of November, 1951

My commission expires July 19, 1955 Notary Public

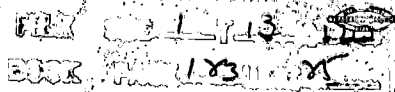

WELL LOG

COMPANY: W.J. COPPINGER

NE-SE-NE Sec.1,
Twp. 13S, Rge.17W,
Ellis County, Ks.

LEASE: BRUNGARDT # 1,

ELEVATION: 2094 Derrick Floor.

NOTE: All meas. rotary bushings.

0	60 Post rock
60	125 Shale
125	216 Shale
216	230 Blue shale
230	620 Shale & shells
620	730 Shale
730	840 Sand
840	1115 Redbed
1115	1201 Redbed & shale
1201	1215 Anhydrite
1215	1248 Anhydrite
1248	1515 Shale & redbed
1515	1720 Shale & salt
1720	1860 Shale
1860	1950 Shale
1950	1975 Shale & lime
1975	2120 Shale & lime
2120	2220 Lime
2220	2280 Lime
2280	2320 Lime
2320	2415 Lime
2415	2490 Lime
2490	2590 Lime & shale
2590	2800 Shale
2800	2990 Shale
2930	3040 Shale
3040	3080 Lime & shale
3080	3090 nLime
3090	3135 Lime
3165	3220 Lime
3220	3251 Lime
3251	3320 Lime
3320	3378 Lime
3378	3427 Lime
3427	3463 Lime
3463	3520 Lime
3520	3570 Lime
3570	3575 Arbuckle
3575	3593 Arbuckle
3593	3615 Arbuckle
3615	T.D. R.B. Meas.

TOPS:

Anhydrite	1201	Congl.	3533'
Heebner	3245	Arbuckle	3564
Lans. (K.C.)	3293	T.D.	3615

D.S.T. by Johnston Testing Co.

3566-3575 Tool open 1 Hour. Weak blow 12 min. Recovered 25' Drilling Mud. B.H.P. 20 min 690#.

3575-3593 Tool open 1 Hour. Recovered 85 feet Salt water and mud. B.H.P. 20 min. 800#.

Ran Schlumberger Log to total Depth.

CASING RECORD:

8 5/8" Surface Casing set at 216' w/150 lbs cement & 2CC. by Golbe Cementing Company

COMMENCED: 10-24-51

COMPLETED: 11-8-51

STATE OF KANSAS) 33
COUNTY OF ELLIS)

11-13-1951

I hereby affirm that the above and foregoing is a true and correct copy of the log of the Brungardt #1, located NE-SE-NE Sec.1 Twp. 13S, Rge. 17W, Ellis County, Kansas.

CONTRACTOR Stain Drilling Company

Subscribed and sworn to me before this 9 day of November, 1951

My Commission expires July 16, 1955.

Palmer Anna Linn
NOTARY PUBLIC.

FILED
FILE SEC. 17.13R.112
BOOK PAGE 22 LINE 26