


STATE OF KANSAS  
STATE CORPORATION COMMISSION  
200 Colorado Derby Bldg.  
Wichita, Kansas 67202

Form CP-4  
Rev. 12-15-80

WELL PLUGGING RECORD

Give All Information Completely  
Make Required Affidavit

COUNTY Ellis SEC. 8 TWP. 13S RGE. 17 E/W  
Location as in quarters or footage from lines:  
330ft from S. Line and 330 ft from West Line of the SE 1/4

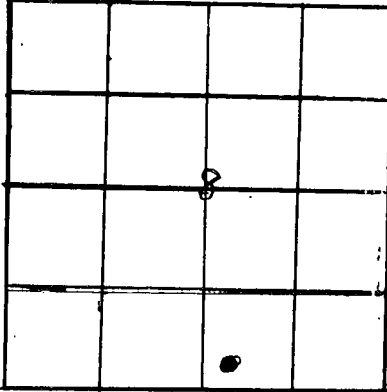

Locate Well  
correctly on above  
Section Platt.

Lease Owner Ernst & Steinkle Oil  
Lease Name L. Staab Well No. #2  
Office Address Box 859, Russell, Ks. 67665  
Character of Well (Completed as Oil, Gas or Dry Hole): \_\_\_\_\_  
Date Well Completed drilled 1-83  
Application for plugging filed verbal - 5-1-83 - Gilbert Scheck  
Plugging commenced 5-4-83  
Plugging completed 5-11-83  
Reason for abandonment of well or producing formation  
Non-commercial production

Was permission obtained from the Conservation Division or it's  
Agent's before plugging was commenced? Yes

Name of Conservation Agent who supervised plugging of this well Gilbert Scheck  
Producing formation Arbuckle Depth to top \_\_\_\_\_ bottom \_\_\_\_\_ T.D. \_\_\_\_\_  
Show depth and thickness of all water, oil and gas formations.

OIL, GAS OR WATER RECORDS

Casing Record

Formation	Content	From	To	Size	Put in	Pulled Out
				5 1/2	3649'	2100'

Describe in detail the manner in which the well was plugged, indicating where the mud  
fluid was placed and the method or methods used in introducing it into the hold. If cement  
or other plugs were used, state the character of same and depth placed, from \_\_\_\_\_ feet  
to \_\_\_\_\_ feet for each plug set. 5 sx cement on bottom  
bridge 50' w/sand  
5 sx cement on top of sand  
shot off casing @ 2100', pulled casing  
Top Stage: \_\_\_\_\_  
4 sxs hulls STATE CORPORATION COMMISSION  
15 sks gel  
65 sks cement JUN 06 1983  
5 sks gel  
1 sk hulls CONSERVATION DIVISION  
8 5/8" plug Wichita, Kansas  
100 sks cement to surface


(If additional description is necessary, use BACK of this sheet)

Name of Plugging Contractor Five Star Well Service & Sun Cementing

STATE OF Kansas COUNTY OF Russell, ss.  
Fred Ernst (employee of owner) or (owner or operator) of the  
above-described well, being first duly sworn on oath, says: That I have knowledge of the  
facts, statements, and matters herein contained and the log of the above-described well as  
filed and that the same are true and correct. So help me God.

(Signature) Fred Ernst  
1025 Main Russell, Kas  
(Address)

SUBSCRIBED AND SWORN TO before me this 31<sup>st</sup> day of May, 1983

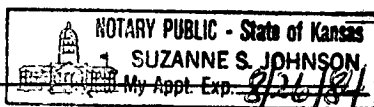

Suzanne S. Johnson  
Notary Public.

My Commission expires: \_\_\_\_\_