


WELL PLUGGING RECORD

Give All Information Completely
Make Required Affidavit
Mail or Deliver Report to:
Conservation Division
State Corporation Commission
800 Bitting Building
Wichita, Kansas

NORTH

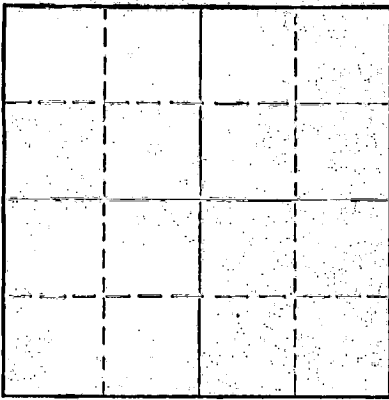

Locate well correctly on above
Section Plat

Ellis County, Sec. 8, Twp. 13S Rge. (E) 17(W)
Location as "NE/CNW $\frac{1}{4}$ /SW $\frac{1}{4}$ " or footage from lines NW $\frac{1}{4}$, NE $\frac{1}{4}$, SW $\frac{1}{4}$
Lease Owner Aylward Drilling Company et al
Lease Name Leikau Well No. 1
Office Address 813 First Nat'l. Bank Bldg., Wichita 2, Kansas
Character of Well (completed as Oil, Gas or Dry Hole) Dry
Date well completed December 8, 19 51
Application for plugging filed December 8, 19 51
Application for plugging approved 19
Plugging commenced December 8, 19 51
Plugging completed December 8, 19 51
Reason for abandonment of well or producing formation Dry

If a producing well is abandoned, date of last production 19
Was permission obtained from the Conservation Division or its agents before plugging was commenced? Yes

Name of Conservation Agent who supervised plugging of this well
Producing formation Depth to top Bottom Total Depth of Well 3633 Feet
Show depth and thickness of all water, oil and gas formations.

OIL, GAS OR WATER RECORDS

CASING RECORD

Formation	Content	From	To	Size	Put In	Pulled Out
				8-5/8	125'	None

Describe in detail the manner in which the well was plugged, indicating where the mud fluid was placed and the method or methods used in introducing it into the hole. If cement or other plugs were used, state the character of same and depth placed, from feet to feet for each plug set.

Filled hole with mud from 3633' to 125', set bottom plug at 125', rock and hulls and 15 sax on plug, top plug at 40', 10 sax on top plug. Top and bottom plugs were brush, rock and hulls and held weight of drill pipe. Cement put in through surface pipe mixed in barrel.

(If additional description is necessary, use BACK of this sheet)

Correspondence regarding this well should be addressed to Aylward Drilling Company
Address 813 First National Bank Bldg., Wichita 2, Kansas

STATE OF KANSAS, COUNTY OF SEDGWICK, ss.
L. W. Aylward (employee of owner) or (owner or operator) of the above-described well,
being first duly sworn on oath, says: That I have knowledge of the facts, statements, and matters herein contained and the log of the above-described well as filed and that the same are true and correct. So help me God.

(Signature) *[Signature]*
Hoisington, Kansas
(Address)

SUBSCRIBED AND SWORN TO before me this 12th day of December, 1951.
[Signature]
Notary Public.

My commission expires July 5, 1952

W. F. Skelton
Notary Public
My commission expires July 5, 1952

LEIKAM #1

Casing Records: 8-5/8" - 125'	Company: Aylward Drilling Company Et Al Contractor: Aylward Drilling Company Commenced: November 27, 1951 Completed: December 8, 1951	Description: NW NE NW Sec. 8-13-17 Ellis County, Kansas Elev: 2019 D.F. 2016 Ground Pot. D. & A.
----------------------------------	---	---

	<u>From</u>	<u>To</u>	<u>Remarks</u>
Soil, Clay & Shale	0	125	Set 8-5/8" casing at 125' and cemented with 75 sax.
Shale & Shells	125	565	
Shale, Sand & Streak Iron	565	650	
Shells & Sand Shale	650	785	
Sand	785	825	
Red bed & Sand	825	1240	
Lime	1240	1250	
Anhydrite	1250	1260	
Shale & Shells	1260	1860	
Shale & Lime	1860	2290	
Lime	2290	2455	
Shale & Lime	2455	2735	
Shale & Shells	2735	2920	
Lime & Shale	2920	3115	
Lime	3115	3633	

FORMATION TOPS:

Stone Corral Anhydrite	1240	- 1260
Possible top Topeka	3038	
Reelmer Shale	3287	
Toronto	3309	
Lansing	3331	
Base Kansas City	3564	
Harmston	3564	- 3586
Conglomerate	3586	- 3589
Simpson	3589	- 3594
Broken Arbuckle	3594	- 3599
Solid Arbuckle	3599	

I certify that this is a true and correct copy of the above log to the best of my knowledge.

Subscribed and sworn to before me this 17th day of December, 1951.

Al Gralsky

 Al Gralsky

AnnaBeth Huffine

 Notary Public

AnnaBeth Huffine
 Notary Public
 My commission expires April 6, 1955

FILE 8 13 170
 130 45

12-18-1951