


STATE OF KANSAS  
STATE CORPORATION COMMISSION

Give All Information Completely  
Make Required Affidavit  
Mail or Deliver Report to:  
Conservation Division  
State Corporation Commission  
212 No. Market  
Wichita, Kansas

WELL PLUGGING RECORD

NORTH

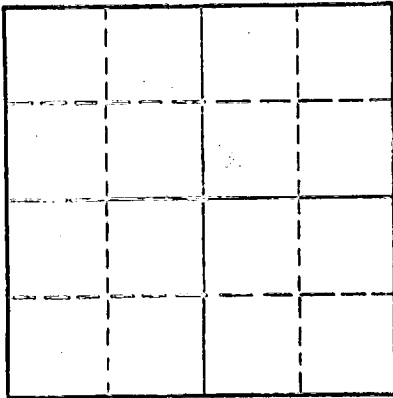

Locate well correctly on above  
Section Plat

Ellis County, Sec. 8 Twp. 13 Rge. 17 (E) W (W)  
Location as "NE/CNW/SW" or footage from lines S71-S2-S3  
Lease Owner Don E. Pratt Oil Operations  
Lease Name Staab Well No. 2  
Office Address P.O. Box # 370 Hays, Kansas  
Character of Well (completed as Oil, Gas or Dry Hole) Dry  
Date well completed 5-11- 19 66  
Application for plugging filed 5-11-19 66  
Application for plugging approved 5-11-19 66  
Plugging commenced 5-11-19 66  
Plugging completed 5-11-19 66  
Reason for abandonment of well or producing formation Dry Stagnant

If a producing well is abandoned, date of last production \_\_\_\_\_ 19 \_\_\_\_  
Was permission obtained from the Conservation Division or its agents before plugging was commenced? Yes

Name of Conservation Agent who supervised plugging of this well Leo Massey - Hays, Kansas  
Producing formation \_\_\_\_\_ Depth to top \_\_\_\_\_ Bottom \_\_\_\_\_ Total Depth of Well 3619' Feet  
Show depth and thickness of all water, oil and gas formations.

OIL, GAS OR WATER RECORDS

CASING RECORD

FORMATION	CONTENT	FROM	TO	SIZE	PUT IN	PULLED OUT
SURFACE PIPE				8-5/8"	168	

Describe in detail the manner in which the well was plugged, indicating where the mud fluid was placed and the method or methods used in introducing it into the hole. If cement or other plugs were used, state the character of same and depth placed, from \_\_\_\_\_ feet to \_\_\_\_\_ feet for each plug set.

Filled hole with rotary mud to a depth of 540' where 1st plug was set using 20 sax cement. Filling hole with rotary mud to a depth of 160' where 2nd plug was set using 20 sax cement. Rotary mud was used to fill hole to a depth of 40' where 3rd plug was set using 10 sax & 1/2 sax Halls and filling hole to surface.

RECEIVED  
JUN - 3 1966  
06-03-1966

(If additional description is necessary, use BACK of this sheet)

Name of Plugging Contractor L.J. Dreiling & Sons, Inc.  
Address Victoria, Kansas

STATE OF Kansas, COUNTY OF Ellis, ss.  
I, Leo F. Dreiling (employee of owner) ~~or (owner or contractor)~~ of the above-described well, being first duly sworn on oath, says: That I have knowledge of the facts, statements, and matters herein contained and the log of the above-described well as filed and that the same are true and correct. So help me God.

(Signature) Leo F. Dreiling  
LEO F. DREILING VICTORIA, KANSAS  
(Address)

SUBSCRIBED AND SWORN to before me this 12th day of May, 19 66

My commission expires October 26, 1968  
Elmer Welch Notary Public.

L. J. DREILING and SONS, Inc.

VICTORIA, KANSAS

WELL LOG

Company Don E. Pratt Oil Operations  
Hays, Kansas P.O.Box# 370

Farm Staab No. 2

Total Depth 3619'

Comm. 5- 5- 66 Comp. 5- 11- 66

Contractor L. J. Dreiling & Sons, Inc.  
Victoria, Kansas

Casing Record

Cement Record

168' 8-5/8"

125 HA-5

Sec. 8- Twp. 13 Rng. 17

Location SW- SE- SE

County Ellis

Elevation: D. F.  
K.B. 2014'  
G. R.

Production:

D & A

Figures Indicate Bottom of Formations

0'	20'	Surface Soil & Clay
20'	70'	Sand & Gravel
70'	168'	Shale
168'	480'	Shale
480'	738'	Shale & Sand
738'	909'	Sand
909'	1252'	Shale & Redbed
1252'	1296'	Anhy.
1296'	1485'	Shale & Shells
1485'	1660'	Shale & Shells
1660'	1910'	Shale & Salt
1910'	2005'	Shale & Lime Stks.
2005'	2300'	Shale & Lime
2300'	2525'	Lime & Shale
2525'	2780'	Shale & Lime
2780'	3065'	Shale & Lime
3065'	3219'	Lime & Shale
3219'	3300'	Lime
3300'	3424'	Lime
3424'	3490'	Lime
3490'	3572'	Lime
3572'	3604'	Lime
3604'	3614'	Lime
3614'	3619'	Lime
3619'	T.D.	

STATE OF KANSAS )  
                                  )ss  
COUNTY OF ELLIS )

I, Leo F. Dreiling, of the L. J. Dreiling & Sons, Inc. upon oath states that the above and foregoing is a true and correct copy from the Daily Drilling Report from your Staab # 2.

*Leo F. Dreiling*  
LEO F. DREILING

Subscribed and sworn to before me this 11th, day of May, 1966.

*Emory Ruff*  
NOTARY PUBLIC

My commission expires: October 26, 1968

JUN - 9 1966  
06-03-1966  
RECORDS DIVISION  
KANSAS