


STATE OF KANSAS  
STATE CORPORATION COMMISSION

Give All Information Completely  
Make Required Affidavit  
Mail or Deliver Report to:  
Conservation Division  
State Corporation Commission  
212 No. Market  
Wichita, Kansas

WELL PLUGGING RECORD

Ellis County, Sec. 8 Twp. 13S Rge. 17 (E) 7 (W)

Location as "NE/CNW%SW%" or footage from lines C-3/2 N/2 E/2  
 Lease Owner Raymond Oil Co., Inc.  
 Lease Name Raymond Polifka Well No. 1  
 Office Address 110 Fourth National Bank Bldg., Wichita, Kans.  
 Character of Well (completed as Oil, Gas or Dry Hole) Oil  
 Date well completed \_\_\_\_\_ 19\_\_\_\_  
 Application for plugging filed October 10, 1966  
 Application for plugging approved October 13, 1966 19\_\_\_\_  
 Plugging commenced October 26 1966  
 Plugging completed October 29 1966  
 Reason for abandonment of well or producing formation No longer commercially productive  
 If a producing well is abandoned, date of last production 10-8-66 19\_\_\_\_  
 Was permission obtained from the Conservation Division or its agents before plugging was commenced? Yes

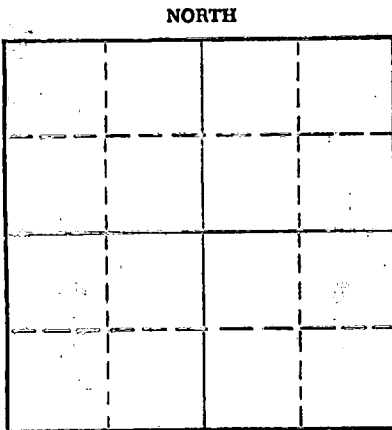

Locate well correctly on above Section Plat

Name of Conservation Agent who supervised plugging of this well Leo Massey  
 Producing formation \_\_\_\_\_ Depth to top \_\_\_\_\_ Bottom \_\_\_\_\_ Total Depth of Well 3605 Feet  
ANB KCC  
 Show depth and thickness of all water, oil and gas formations.

OIL, GAS OR WATER RECORDS

CASING RECORD

FORMATION	CONTENT	FROM	TO	SIZE	PUT IN	PULLED OUT
				8 5/8"	190'	
				5 1/2"	3595	

Describe in detail the manner in which the well was plugged, indicating where the mud fluid was placed and the method or methods used in introducing it into the hole. If cement or other plugs were used, state the character of same and depth placed, from \_\_\_\_\_ feet to \_\_\_\_\_ feet for each plug set.

Sanded back 30' in the 5 1/2" and cased 5 sacks of cement. Set pipe off at 2875.15'.  
 Pulled pipe and squeezed 25 sacks of Jet-Lid and 65 sacks of cement with Ball-Burner.

NOV 10 1966  
 11-10-1966  
 CONSERVATION DIVISION  
 WICHITA, KANSAS

(If additional description is necessary, use BACK of this sheet)


Name of Plugging Contractor Bert Self  
 Address Hutchinson, Kans.

STATE OF Kans. COUNTY OF Reno, ss.  
Employee (employee of owner) or (owner or operator) of the above-described well, being first duly sworn on oath, says: That I have knowledge of the facts, statements, and matters herein contained and the log of the above-described well as filed and that the same are true and correct. So help me God.

(Signature) Bert Self  
R. R. #1, Hutchinson, Kans.  
 (Address)

Subscribed and sworn to before me this 7th day of November, 1966

My commission expires Oct 10, 1969  
Bert Self Notary Public.

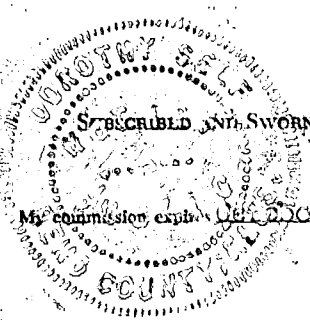

RAYMOND OIL COMPANY, INC.  
#1 POLIFKA  
C-S/2-N/2-N/2  
Sec. 8-13S-17W  
Ellis County, Kansas

ELEVATION: 2038 KB  
2035 DF  
2033 GL

Drilling Contractor:	Company Tools	Casing Record
Commenced:	November 8, 1965	190' 8 5/8" w/150 sx.
Completed:	November 17, 1965	3595' 5 1/2" w/125 sx.

Figures Indicate Bottom of Formation

Sand & Shale	190
Shale & Red Bed	490
Sand & Shale	930
Red Bed & Shale	1294
Anhydrite	1316
Shale & Chalk	1326
Red Bed & Shale	1410
Shale & Shells	1875
Lime & Shale	2040
Lime with Shale	2250
Lime & Shale	3140
Lime	3550
Shale & Lime	3608
RTD	3608

RECEIVED  
OCT 13 1965  
10-13-1965  
CONSERVATION DIVISION  
WANDA, KANSAS

STATE OF KANSAS            )  
  ) SS:  
COUNTY OF SEDGWICK    )

I hereby certify that the above is true and correct to the best of my knowledge.

Wm M Raymond  
Wm. M. Raymond

Subscribed and sworn to before me, this 22nd day of November, 1965.

Ronnie Donnelly  
Ronnie Donnelly - Notary Public

My commission expires:  
February 15, 1967

