


WELL PLUGGING RECORD

Give All Information Completely
Make Required Affidavit.
Mail or Deliver Report to:
Conservation Division
State Corporation Commission
212 North Market, Insurance Bldg.
Wichita, Kansas

NORTH

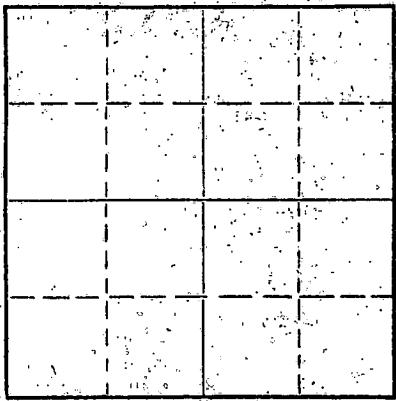

Locate well correctly on above
Section Plat

Ellis County, Sec. 11 Twp. 13 Rge. (E) 17 (W)
Location as "NE/CNW/SW" or footage from lines SW - NW - SW
Lease Owner Wilkinson Drilling Company
Lease Name Dreiling Well No. 1
Office Address Great Bend, Kansas
Character of Well (completed as Oil, Gas or Dry Hole)
Date well completed 19
Application for plugging filed 19
Application for plugging approved 19
Plugging commenced 7-30 19 59
Plugging completed 8-1 19 59
Reason for abandonment of well or producing formation

If a producing well is abandoned, date of last production 19
Was permission obtained from the Conservation Division or its agents before plugging was commenced? Yes

Name of Conservation Agent who supervised plugging of this well Eldon Petty
Producing formation Depth to top Bottom Total Depth of Well Feet
Show depth and thickness of all water, oil and gas formations.

OIL, GAS OR WATER RECORDS

CASING RECORD

FORMATION	CONTENT	FROM	TO	SIZE	PUT IN	PULLED OUT
				8 5/8	201	None
				5 1/2	3532	2768.07

Describe in detail the manner in which the well was plugged, indicating where the mud fluid was placed and the method or methods used in introducing it into the hole. If cement or other plugs were used, state the character of same and depth placed, from feet to feet for each plug set.

Sanded to 3520' - dumped 4 sks of cement - pumped 30 sks of mud through casing - spotted 20 sks of cement @ 490' - pulled casing to 160' - spotted 20 sks of cement - finished pulling casing - set rock bridge - dumped 10 sks of cement to top of hole.

RECEIVED
STATE CORPORATION COMMISSION

AUG 18 1959

CONSERVATION DIVISION
Wichita, Kansas

0-8-18-1959

(If additional description is necessary, use BACK of this sheet)
Name of Plugging Contractor R & D Casing Pulling Company License # 236
Address Box 569 Ellinwood, Kansas

STATE OF Kansas, COUNTY OF Sedgwick, ss.
Walter M. Wilkinson (employee of owner) or (owner or operator) of the above-described well, being first duly sworn on oath, says: That I have knowledge of the facts, statements, and matters herein contained and the log of the above-described well as filed and that the same are true and correct. So help me God.

(Signature) Walter M. Wilkinson
1121 Union National Bldg., Wichita 2, Kansas
(Address)

SUBSCRIBED AND SWORN TO before me this 17th day of August, 19 59

Carolyn F. Moore
Notary Public.

My commission expires January 2, 1961

PLUGGING
FILE SEC. 11, T. 13, R. 17W
BOOK PAGE 52 LINE 221

15-051-05535-00-00
 WELL LOG BUREAU—KANSAS GEOLOGICAL SOCIETY
 508 East Murdock, Wichita, Kansas


COPY

Company- WILKINSON DRG., INC.
 Farm- P.J. Dreiling No. 1

SEC. 11 T. 13 R. 17W
 SW NW SW

Total Depth. 3541'
 Comm. 4-8-57 Comp. 4-18-57
 Shot or Treated.
 Contractor. Company Tools.
 Issued. 10-12-57

County Ellis
 KANSAS

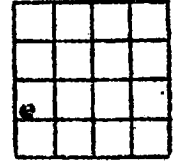

CASING:
 8 5/8" 201.41'
 5" 3532'

Elevation. 2016' DF

Production. 315 BOPD

Figures indicate Bottom of Formations.

surface soil-shale	200
shale-red beds	440
shale-shells	1190
Anhydrite	1225
shale-shells	1860
lime-shale	3261
lime	3524
Dolonite	3541
Total Depth	
TOPS: Scout	
Anhydrite	1190
Heebner	3228
Lansing	3273
Arbuckle	3524

3228
 2018

 10