


Give All Information Completely  
Make Required Affidavit  
Mail or Deliver Report to:  
Conservation Division  
State Corporation Commission  
212 No. Market  
Wichita, Kansas

WELL PLUGGING RECORD

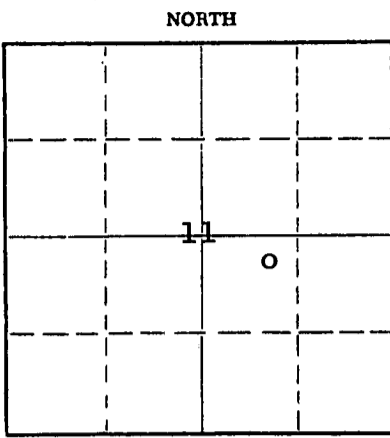

Locate well correctly on above Section Plat

Ellis County, Sec. 11 Twp. 13S Rge. 17 (E) 17 (W)  
Location as "NE/CNW/SW" or footage from lines NE NW SE  
Lease Owner Rains & Williamson Oil Co., Inc.  
Lease Name KARLIN Well No. 1  
Office Address 1425 Wichita Plaza - Wichita, Kansas  
Character of Well (completed as Oil, Gas or Dry Hole) Oil  
Date well completed 4-5 19 63  
Application for plugging filed 5-29 19 68  
Application for plugging approved 5-29 19 68  
Plugging commenced 5-29 19 68  
Plugging completed 5-29 19 68  
Reason for abandonment of well or producing formation Depleted

If a producing well is abandoned, date of last production 19  
Was permission obtained from the Conservation Division or its agents before plugging was commenced? Yes

Name of Conservation Agent who supervised plugging of this well Leo Massey, Hays, Kans.  
Producing formation Arbuckle Depth to top 3544 Bottom 3546 DD\* Total Depth of Well 3577 \* Feet  
Show depth and thickness of all water, oil and gas formations.

OIL, GAS OR WATER RECORDS

CASING RECORD

FORMATION	CONTENT	FROM	TO	SIZE	PUT IN	PULLED OUT
				8-5/8"	160'	-0-
				5-1/2"	3546'	2909'

RECEIVED  
STATE CORPORATION COMMISSION  
JUN 24 1968  
CONSERVATION DIVISION  
Wichita, Kansas  
06-24-1968

Describe in detail the manner in which the well was plugged, indicating where the mud fluid was placed and the method or methods used in introducing it into the hole. If cement or other plugs were used, state the character of same and depth placed, from \_\_\_\_\_ feet to \_\_\_\_\_ feet for each plug set.

Set plug at 3300'. Ran in 5 sacks cement from 3300-3270'.  
Pulled pipe and pumped in 5 sacks of hulls, 20 sacks of mud and 130 sacks of cement and plugged well.

Permit No. 396

(If additional description is necessary, use BACK of this sheet)  
Name of Plugging Contractor Glenn & Smith Pipe Pulling Company  
Address Box 156, Ellinwood, Kansas

STATE OF KANSAS, COUNTY OF SEDGWICK, ss.  
Wilson Rains (employee or owner) or (owner or operator) of the above-described well, being first duly sworn on oath, says: That I have knowledge of the facts, statements, and matters herein contained and the log of the above-described well as filed and that the same are true and correct. So help me God.  
(Signature) Wilson Rains Wilson Rains  
1425 Wichita Plaza - Wichita, Kansas  
(Address)

SUBSCRIBED AND SWORN TO before me this 21st day of June, 19 68

My commission expires June 30, 1971 Sherry Gish Notary Public.

WELL LOG BUREAU - KANSAS GEOLOGICAL SOCIETY  
 508 East Murdock, Wichita, Kansas


15-051-01579-00-00

Company- ALPINE OIL & ROYALTY CO. INC.  
 Farm- Alvin Karlisn No. 1

SEC. 11 T. 13 R. 17W  
 NE NW SE

Total Depth. 3550'  
 Comm. 3-20-63 Comp. 4-5-63  
 Shot or Treated.  
 Contractor. Quaker Drilg. Co.  
 Issued. 10-5-63

County Ellis  
 KANSAS

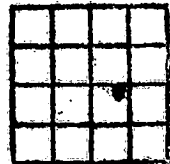

Elevation. 2029' KB

Production. 52BOPD plus 20% Wtr

Figures Indicate Bottom of Formations.

surface soil & shale	160	
shale	755	
sand	900	
shale & shells	1198	
anhydrite	1236	
shale & shells	1385	
red bed, shale & shells	1875	
lime & shale	3035	
lime	3130	
lime & shale	3340	
lime	3550	RTD
Total Depth		
TOPS: SMP		
Anhydrite	1198	
Heebner	3245	
Toronto	3292	
Base Kansas City	3521	
Conglomerate	3531	
Arbuckle	3544	

RECEIVED  
 STATE CORPORATION COMMISSION  
 MAY 27 1968  
 CONSERVATION DIVISION  
 Wichita, Kansas  
 05-27-1968

3245  
 2029  
 16