


Give All Information Completely
Make Required Affidavit
Mail or Deliver Report to:
Conservation Division
State Corporation Commission
800 Bittling Building
Wichita, Kansas

WELL PLUGGING RECORD

NORTH

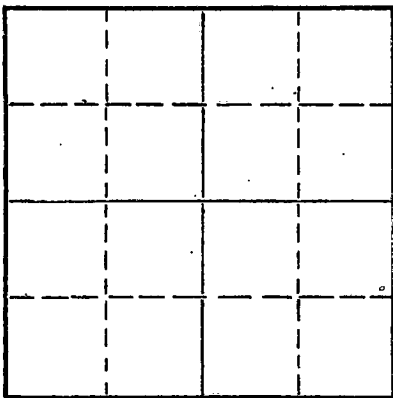

Locate well correctly on above
Section Plat

Ellis County, Sec. 11 Twp. 13 Rge. 17 XXXXXX (W)
Location as "NE/CNW/SW" or footage from lines SE SW SE 11-13-17W
Lease Owner K & E Drilling, Inc. & Century Production Co.
Lease Name Karlin Well No. #1
Office Address 1006 Central Bldg., Wichita, Kansas
Character of Well (completed as Oil, Gas or Dry Hole) dry hole
Date well completed July 9, 19 55
Application for plugging filed July 9, 19 55
Application for plugging approved July 9, 19 55
Plugging commenced July 9, 19 55
Plugging completed July 9, 19 55
Reason for abandonment of well or producing formation commercial quantities of oil
not found
If a producing well is abandoned, date of last production 19
Was permission obtained from the Conservation Division or its agents before plugging was com-
menced? yes

Name of Conservation Agent who supervised plugging of this well Eldon Petty
Producing formation Depth to top Bottom Total Depth of Well Feet
Show depth and thickness of all water, oil and gas formations.

OIL, GAS OR WATER RECORDS

CASING RECORD

FORMATION	CONTENT	FROM	TO	SIZE	PUT IN	PULLED OUT
				8 5/8	130	none

Describe in detail the manner in which the well was plugged, indicating where the mud fluid was placed and the method or methods used
in introducing it into the hole. If cement or other plugs were used, state the character of same and depth placed, from feet to
feet for each plug set.

Filled hole with heavy mud from 3607 to 125'. Set wooden plug
with 15 sacks cement. Second plug at 40' with 10 sacks cement.

(If additional description is necessary, use BACK of this sheet)

Name of Plugging Contractor K & E Drilling, Inc.
Address 1006 Central Bldg., Wichita, Kansas

STATE OF Kansas, COUNTY OF Sedgwick, ss.
Dale Silcott


(employee of ~~owner~~ or operator) of the above-described
well, being first duly sworn on oath, says: That I have knowledge of the facts, statements, and matters herein contained and the log of the
above-described well as filed and that the same are true and correct. So help me God.

(Signature) Dale Silcott
1006 Central Bldg., Wichita, Kansas
(Address)

SUBSCRIBED AND SWORN to before me this 12th day of July, 19 55

My commission expires June 25, 1956

Notary Public.

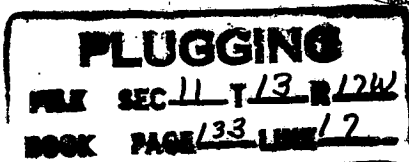

07-14-1955

K & E DRILLING, INC. & CENTURY PRODUCTION CO.
Karlin #1

15-051-04015-00-00
SE SW SE Sec. 11-13-17W
Ellis County, Kansas

Comm: June 27, 1955
Comp: July 9, 1955
Total depth: 3607'

<u>Casing</u>	<u>Cement</u>
Set 8 5/8" @ 130'	80 sacks
<u>FORMATION</u>	<u>DEPTH</u>
Surface Sand and Soil	0- 130
Shale	130- 720
Sand	720- 830
Red bed	830-1190
Anhydrite	1190-1225
Shale-shells	1225-1970
Shale-lime	1970-3295
Lime	3295-3327
Lime & shale	3327-3393
Lime	3393-3564
Cherty Conglomerate	3564-3579
Lime (Arbuckle)	3579-3607

STATE OF KANSAS)
) SS
COUNTY OF SEDGWICK)

I hereby certify that the above information is true and correct to the best of my knowledge.



Subscribed and sworn to before me this 12th day of July, 1955.


Notary Public

My commission expires: June 25, 1956

