

15-051-19356-00-00

WELL PLUGGING RECORD

Give All Information Completely
Make Required Affidavit
Mail or Deliver Report to:
Conservation Division
State Corporation Commission
211 No. Broadway
Wichita, Kansas

Ellis County, Sec. 11 Twp. 13S Rge. 17W (E) (W)

Location as "NE/CNW/SE" or footage from lines SE SW NE

Lease Owner ALPINE OIL & ROYALTY CO., INC.

Lease Name Rome Well No. 1

Office Address 800 Bitting Building, Wichita, Kansas

Character of Well (completed as Oil, Gas or Dry Hole) oil well

Date well completed May 28, 1963 19

Application for plugging filed December 30, 1963 19

Application for plugging approved December 31, 1963 19


Plugging commenced January 3, 1964 19

Plugging completed January 6, 1964 19

Reason for abandonment of well or producing formation non-productive in commercial quantities

If a producing well is abandoned, date of last production December 23, 1963

Was permission obtained from the Conservation Division or its agents before plugging was commenced? yes

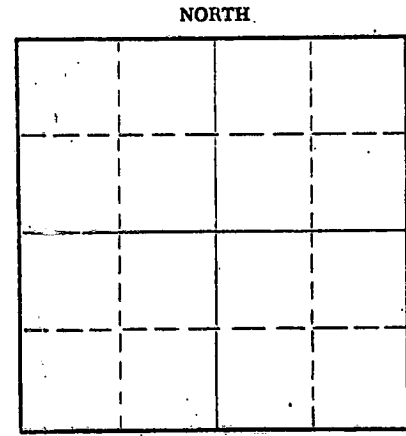

Locate well correctly on above Section Plat

Name of Conservation Agent who supervised plugging of this well Eldon Petty

Producing formation Lansing-KC Depth to top 3298 Bottom 3529 Total Depth of Well 3583 1/2 Feet

Show depth and thickness of all water, oil and gas formations.

OIL, GAS OR WATER RECORDS

CASING RECORD

FORMATION	CONTENT	FROM	TO	SIZE	PUT IN	PULLED OUT
				8 5/8"	164'	Cemented
				5 1/2"	3562'	2915'

Describe in detail the manner in which the well was plugged, indicating where the mud fluid was placed and the method or methods used in introducing it into the hole. If cement or other plugs were used, state the character of same and depth placed, from _____ feet to _____ feet for each plug set.

Ran plug to 3300 feet, sand and 4 sacks of cement
3300 feet to 3260 feet - pumped mud and 20 sacks
cement at 550 feet. Pumped 20 sacks of cement at 180
feet. Pumped 10 sacks of cement from 30 feet to base
of cellar.

RECEIVED
STATE CORPORATION COMMISSION

JAN 21 1964

01-21-1964

CONSERVATION DIVISION
Wichita, Kansas

(If additional description is necessary, use BACK of this sheet)

Name of Plugging Contractor GLENN AND SMITH PIPE PULLING COMPANY

Address Box 156 - Ellinwood, Kansas

STATE OF Kansas COUNTY OF Sedgwick ss.

Thomas M. McCaul

(employee of owner) or (owner or operator) of the above-described well, being first duly sworn on oath, says: That I have knowledge of the facts, statements, and matters herein contained and the log of the above-described well as filed and that the same are true and correct. So help me God.

(Signature)

800 Bitting Building, Wichita, Kansas

(Address)

SUBSCRIBED AND SWORN to before me this 20th day of January 19 64

My commission expires August 10, 1965

Notary Public.

WELL LOG

ALPINE OIL & ROYALTY CO., INC. Commenced: May 19, 1963
 CONTRACTOR: Quaker Drilling Co., Inc. Completed: May 28, 1963
 Rome No. 1 Elevation: 2035 K. B.
 SE SW NE Sec. 11-13S-17W
 Ellis County, Kansas

Casing Record:

Set 8 5/8 inch casing at 164 feet with 150 sacks cement
 Set 5 1/2 inch casing at 3562 feet with 125 sacks cement

(Figures Indicate the Bottom of the Formations)

<u>FORMATION</u>	<u>DEPTH</u>	<u>FORMATION TOPS</u>	
Clay and Post Rock		Heebner	3252 -1217
Streaks	80	Toronto	3272 -1237
Blue Shale	164	Lansing	3298 -1263
Sandy Shale and Shells	285	Base of Kansas City	3529 -1494
Grey & Red Clay with		Conglomerate	3538 -1503
Shale	580	Arbuckle	3559 -1524
Shale and Shells	730	Rotary Total Depth	3564 -1529
Sand	830		
Red Bed	1198		
Anhydrite	1245		
Shale and Shells	2020		
Lime and Shale	2165		
Sandy Lime and Shale	2330		
Lime and Shale	3095		
Lime	3205		
Lime and Shale	3275		
Lime	3355		
Lime and Shale	3400		
Lime	3445		
Lime and Shale	3564		

RECEIVED
STATE CORPORATION COMMISSION

DEC 31 1963
12-31-1963
CONSERVATION DIVISION
Wichita, Kansas

We hereby certify the foregoing to be a true and correct copy of the Driller's Log of the well drilled in the SE SW NE of Section 11, Township 13 South, Range 17 West, Ellis County, Kansas.

QUAKER DRILLING CO., INC.

By: Thomas W. M. Cuel

SUBSCRIBED and SWORN to before me a Notary Public this 9th day of July, 1963.

MY COMMISSION EXPIRES:
August 10, 1965

Virginia Mundell
Virginia Mundell, Notary Public