

15-051-00129-010-00


STATE OF KANSAS
STATE CORPORATION COMMISSION

WELL PLUGGING RECORD

Give All Information Completely
Make Required Affidavit
Mail or Deliver Report to:
Conservation Division
State Corporation Commission
800 Bitting Building
Wichita, Kansas

Ellis County, Sec. 11 Twp. 13S Rge. 17 (E)W (W)

NORTH

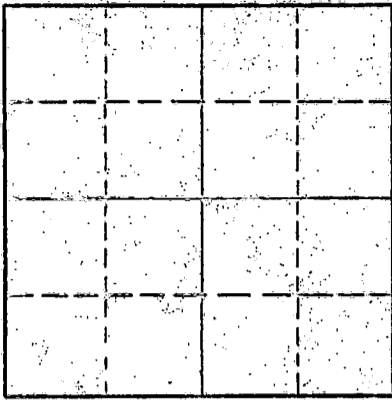

Locate well correctly on above
Section Plat

Location as "NE/CNW/SW" or footage from lines SE SE NE
Lease Owner Rome Victor Drilling, Inc.
Lease Name Rome Well No. 1
Office Address 301 Koch Building, Wichita, Kansas
Character of Well (completed as Oil, Gas or Dry Hole) dry
Date well completed 10-28- 1952
Application for plugging filed 10-28- 1952
Application for plugging approved 10-28- 1952
Plugging commenced 10-28- 1952
Plugging completed 10-28- 1952
Reason for abandonment of well or producing formation no commercial shows

If a producing well is abandoned, date of last production _____ 19____
Was permission obtained from the Conservation Division or its agents before plugging was commenced? YES

Name of Conservation Agent who supervised plugging of this well Edon Petty
Producing formation _____ Depth to top _____ Bottom _____ Total Depth of Well 3590 Feet
Show depth and thickness of all water, oil and gas formations.

OIL, GAS OR WATER RECORDS

CASING RECORD

FORMATION	CONTENT	FROM	TO	SIZE	PUT IN	PULLED OUT
				8 5/8	178	none

Describe in detail the manner in which the well was plugged, indicating where the mud fluid was placed and the method or methods used in introducing it into the hole. If cement or other plugs were used, state the character of same and depth placed, from _____ feet to _____ feet for each plug set.

filled hole with heavy rotary mud from Total Depth 3590 to first plug at 170 feet with 15 sacks cement, filled with heavy rotary mud to 40 feet, second plug with 10 sacks cement.

RECEIVED
NOV 11 05 1952

Name of Plugging Contractor Victor Drilling, Inc.
Address 301 Koch Building, Wichita, Kansas

STATE OF Kansas, COUNTY OF Sedgwick, ss.
Victor E. Reiserer (employee of owner) or (owner or operator) of the above-described well, being first duly sworn on oath, says: That I have knowledge of the facts, statements, and matters herein contained and the log of the above-described well as filed and that the same are true and correct. So help me God.

(Signature) Victor E. Reiserer
301 Koch Building, Wichita 2, Kansas
(Address)

SUBSCRIBED AND SWORN TO before me this 3rd day of November, 1952
Alma E. Rasmussen
Notary Public.

My commission expires July 16, 1955

PLUGGING
PLK SEC 11 T 13 R 1726
BOOK PAGE 55 LINE 22

Victor Drilling, Inc.

No. 1 Rome

SE SE NE Sec. 11-13S-17W
Ellis County, Kansas

Spud: 10-15-52
Comp: 10-28-52

Elevation: 2025 KB.

8 5/8" - 178

clay, sand and shale	0-465
shale and shells	945
red bed & shale	1175
red bed and shale	1190
anhydrite	1225
shale and lime	1570
shale	1825
lime and shale	2055
lime	2150
shale and red bed	2230
lime and shale	2335
shale	2715
shale and lime	2810
shale	2995
lime and shale	3049
lime and shale	3140
lime	3185
lime and shale	3341
lime	3510
lime and shale	3558
lime and dolomite	3590
Total Depth	3590

FORMATION TOPS:

Topeka	3045
Heebner	3254
Lansing-Kansas City	3300
Base Kansas City	3545
Arbuckle	3555

STATE OF KANSAS)
) SS:
COUNTY OF SEDGWICK)

I, Victor F. Reiserer, swear that the foregoing is to the best of my knowledge, correct.

Victor F. Reiserer
Victor F. Reiserer

Subscribed and sworn to before me a notary public, this the 3rd day of November, 1952.

11-05-1952

Anna E. Ross
Notary Public

My commission expires July 16, 1955.

PLUGGING
FILE SEC 11 T 13 N 17 24
BOOK PAGE 55 LINE 22