


STATE OF KANSAS CORPORATION COMMISSION

WELL PLUGGING RECORD

Give All Information Completely Make Required Affidavit Mail or Deliver Report to: Conservation Division State Corporation Commission 211 No. Broadway Wichita, Kansas

ELLIS County, Sec. 11 Twp. 13S Rge. 17W (#) (W)

Location as "NE/CNW/SW" or footage from lines SW NE NE
Lease Owner PETROLEUM, INC.
Lease Name ROME "B" Well No. 1
Office Address ROUTE 2, GREAT BEND, KANSAS
Character of Well (completed as Oil, Gas or Dry Hole) DRY HOLE
Date well completed DECEMBER 5 19 60
Application for plugging filed DECEMBER 5 19 60
Application for plugging approved DECEMBER 5 19 60
Plugging commenced DECEMBER 5 19 60
Plugging completed DECEMBER 5 19 60
Reason for abandonment of well or producing formation ANHYDRITE TOP INDICATED NO FURTHER DRILLING FEASIBLE
If a producing well is abandoned, date of last production NONE 19
Was permission obtained from the Conservation Division or its agents before plugging was commenced? YES

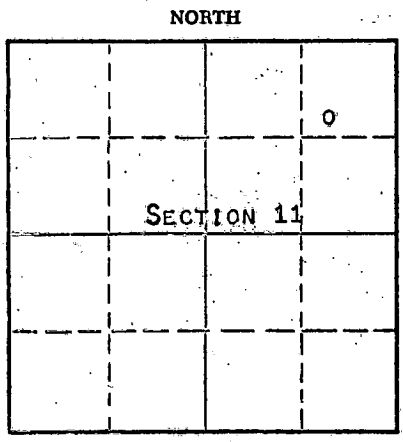

Locate well correctly on above Section Plat

Name of Conservation Agent who supervised plugging of this well ELDON PETTY
Producing formation Depth to top Bottom Total Depth of Well 1265 Feet
Show depth and thickness of all water, oil and gas formations.

OIL, GAS OR WATER RECORDS

CASING RECORD

Table with 7 columns: FORMATION, CONTENT, FROM, TO, SIZE, PUT IN, PULLED OUT. Row 1 contains 'NONE' under SIZE.

Describe in detail the manner in which the well was plugged, indicating where the mud fluid was placed and the method or methods used in introducing it into the hole. If cement or other plugs were used, state the character of same and depth placed, from feet to feet for each plug set.

MUDDERED UP WITH HEAVY MUD TO 500' FOLLOWED BY WOODEN PLUG. PLACED 20 SACKS CEMENT THROUGH DRILL PIPE ON TO PLUG. MUDDERED UP WITH HEAVY MUD TO 180' FOLLOWED BY WOODEN PLUG. PLACED 15 SACKS CEMENT THROUGH DRILL PIPE ON TO PLUG. MUDDERED UP WITH HEAVY MUD TO 35' FOLLOWED BY WOODEN PLUG AND 15 SACKS CEMENT TO BASE OF WELL CELLAR.

12-20-1960

Name of Plugging Contractor GARVEY DRILLING COMPANY
Address ROUTE 2, GREAT BEND, KANSAS

STATE OF KANSAS, COUNTY OF BARTON, ss. DON SEARLE (employee of owner) or of the above-described well, being first duly sworn on oath, says: That I have knowledge of the facts, statements, and matters herein contained and the log of the above-described well as filed and that the same are true and correct. So help me God.

(Signature) Don Searle
ROUTE 2, GREAT BEND, KANSAS (Address)

SUBSCRIBED AND SWORN TO before me this 19TH day of DECEMBER, 19 60

My commission expires APRIL 14, 1963 Notary Public.

WELL LOG

15-051-01314-20-00

COMPANY PETROLEUM, INCORPORATED

SEC. 11 T. 13S R. 17W

FARM ROME "B" NO. 1


LOC. SW, NE, NE

TOTAL DEPTH 1265'

COUNTY ELLIS CO., KANSAS

COMM. December 4, 1960 COMP. December 5, 1960

CONTRACTOR GARVEY DRILLING COMPANY

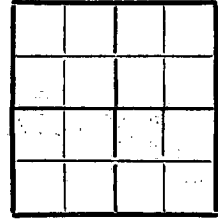

CASING NONE

ELEVATION 2023.5' G.L.

PRODUCTION D & A
(Anhydrite Test)

FIGURES INDICATE BOTTOM OF FORMATIONS

70	Clay & sand
250	Shale
580	Red bed
745	Shale & sand
845	Sand
1200	Shale & red bed
1265	Anhydrite, shale & shells
1265	T. D.

RECEIVED
 STATE OF KANSAS
 DEPARTMENT OF REVENUE
 12-20-1960
 COMMISSIONER'S DIVISION
 TOPEKA, KANSAS

State of KANSAS }
 County of BARTON } ss.

I, VERNE A. MORRIS of GARVEY DRILLING COMPANY

upon oath state that the above and foregoing is a true and correct copy of the log of the #1 ROME "B" well

Verne A. Morris

Subscribed and sworn to before me this 16th day of December 19 60

My Commission Expires: April 14, 1963

Arthur J. Spive
 NOTARY PUBLIC