


WELL PLUGGING RECORD

Give All Information Completely  
Make Required Affidavit  
Mail or Deliver Report to:  
Conservation Division  
State Corporation Commission  
800 Bittling Building  
Wichita, Kansas

NORTH

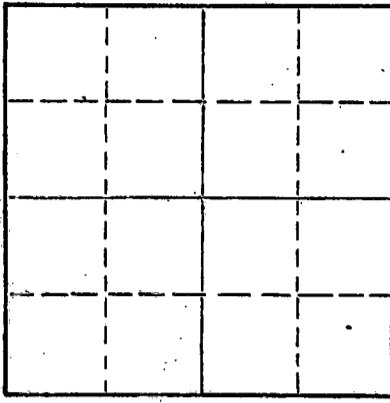

Locate well correctly on above  
Section, Plat

Ellis

County, Sec. 11 Twp. 13S Rge. 17W (E) (W)

Location as "NE/CNW/SW" or footage from lines NW NW SW  
Lease Owner Great Bend Pipe & Supply Company  
Lease Name Dreiling Well No. 1  
Office Address Box 414 - Great Bend, Kansas  
Character of Well (completed as Oil, Gas or Dry Hole) Oil well  
Date well completed May 17 1949  
Application for plugging filed September 13 1955  
Application for plugging approved September 14 1955  
Plugging commenced September 13 1955  
Plugging completed September 16 1955  
Reason for abandonment of well or producing formation Depleted.

If a producing well is abandoned, date of last production \_\_\_\_\_ 19\_\_\_\_  
Was permission obtained from the Conservation Division or its agents before plugging was commenced? Yes

Name of Conservation Agent who supervised plugging of this well Eldon Petty  
Producing formation \_\_\_\_\_ Depth to top \_\_\_\_\_ Bottom \_\_\_\_\_ Total Depth of Well 3560 Feet  
Show depth and thickness of all water, oil and gas formations.

OIL, GAS OR WATER RECORDS

CASING RECORD

FORMATION	CONTENT	FROM	TO	SIZE	PUT IN	PULLED OUT
				10" OD	267'	None
				5" OD	3549'	2671'

Describe in detail the manner in which the well was plugged, indicating where the mud fluid was placed and the method or methods used in introducing it into the hole. If cement or other plugs were used, state the character of same and depth placed, from \_\_\_\_\_ feet to \_\_\_\_\_ feet for each plug set.

Filled the hole with sand from 3560' to 3300' and ran 5 sacks of cement. Mudded the hole to 260', set a 10' rock bridge and ran 20 sacks of cement. Mudded the hole to 30', set a 10' rock bridge and ran 10 sacks of cement on top. Plugging completed.

(If additional description is necessary, use BACK of this sheet)  
Name of Plugging Contractor West Supply Co., Inc.  
Address Chase, Kansas

STATE OF Kansas, COUNTY OF Barton, ss.  
Nathan Meltzer (employee or owner) or (owner or operator) of the above-described well, being first duly sworn on oath, says: That I have knowledge of the facts, statements, and matters herein contained and the log of the above-described well as filed and that the same are true and correct. So help me God.

(Signature) Nathan Meltzer  
West 10th Ct. Bend, Kansas (Address)

SUBSCRIBED AND SWORN to before me this 21st day of September 1955

My commission expires 3-30-57

RECEIVED Notary Public.  
STATE CORPORATION COMMISSION

PLUGGING  
FILE SEC. 11 T. 13 R. 17W  
BOOK PAGE 149 LINE 29

SEP 23 1955  
09-231955  
CONSERVATION DIVISION  
Wichita, Kansas


Company - ANDERSON-PRICHARD OIL CORP.  
Farm -            Drilling        No.    1

SEC. 11        T. 13        R. 17W  
          NW NW SW

Total Depth. 3560  
Comm. 5-3-49            Comp. 5-17-49  
Shot or Treated. 1500 gals. acid  
Contractor. Jones, Shelburne & Farmer, Inc.  
Issued. 12-10-49

County. Ellis

KANSAS

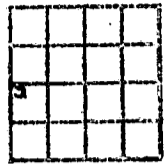

CASING:  
10" set @ 267'  
5" set @ 3549'

Elevation. \_\_\_\_\_

Production. 13 oil & 14% wtr.

Figures Indicate Bottom of Formations.

Surface clay & sand	40
Shale & shells	288
Shale	400
Sand & shale	835
Shale & shells	1190
Anhydrite	1230
Red beds	1495
Shale & shells	1590
Shale & salt	1885
Shale & shells	1890
Shale & lime	2849
Shale & shells	2910
Lime & shale	3278
Lime	3458
Lime & shale	3526
Lime	3541
Lime & shale	3549
Lime	3560

Total Depth

FORMATION TOPS:

Hoebner	3228
Lansing	3274
Arbuckle,	3547

500 acid  $\frac{3}{4}$  BOPH  
1000 acid  $\frac{2}{7}$  BOPH/7 hrs.  
 $\frac{12\frac{1}{2}}$  BO & 2 BW/24 hrs.

**PLUGGING**  
WELL SEC 11 T. 13 R. 17W  
BOOK PAGE 49 LINE 39

RECEIVED  
STATE CORPORATION COMMISSION  
SEP 14 1955  
09-14-1955  
CONSERVATION DIVISION  
WICHITA, KANSAS