


STATE OF KANSAS
STATE CORPORATION COMMISSION

Give All Information Completely
Make Required Affidavit
Mail or Deliver Report to:
Conservation Division
State Corporation Commission
212 No. Market
Wichita, Kansas

WELL PLUGGING RECORD

NORTH

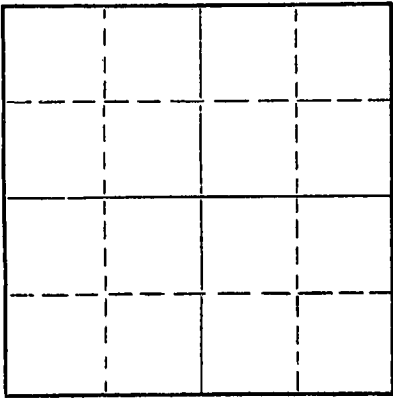

Locate well correctly on above
Section Plat

Ellis County. Sec. 12 Twp. 13S Rge. 17W (X) (W)
Location as "NE/CNWxSWx" or footage from lines SW NW SW
Lease Owner Lee Phillips Oil Company
Lease Name Von Lintel Well No. 1
Office Address 1532 Wichita Plaza, Wichita, Kansas
Character of Well (completed as Oil, Gas or Dry Hole) Dry Hole
Date well completed June 10 1970
Application for plugging filed June 10 1970
Application for plugging approved June 10 1970
Plugging commenced June 10 1970
Plugging completed June 10 1970
Reason for abandonment of well or producing formation Dry Hole

If a producing well is abandoned, date of last production _____ 19____
Was permission obtained from the Conservation Division or its agents before plugging was commenced? yes

Name of Conservation Agent who supervised plugging of this well Leo F. Massey, Hays, Kansas 67601
Producing formation _____ Depth to top _____ Bottom _____ Total Depth of Well 3284 Feet
Show depth and thickness of all water, oil and gas formations.

OIL, GAS OR WATER RECORDS

CASING RECORD

FORMATION	CONTENT	FROM	TO	SIZE	PUT IN	PULLED OUT
<u>Shale</u>		<u>131</u>	<u>210</u>	<u>8 5/8</u>	<u>207</u>	<u>NONE</u>

Describe in detail the manner in which the well was plugged, indicating where the mud fluid was placed and the method or methods used in introducing it into the hole. If cement or other plugs were used, state the character of same and depth placed, from _____ feet to _____ feet for each plug set.

Filled hole with mud to 540' 50 sacks cement and plug,
Filled hole with mud to 180' 25 sacks cement,
Filled hole with mud to 40' sack hulls, plug and 10 sacks cement.
Two sacks in Rat Hole.
Job completed at 6:00 p.m.

RECEIVED
STATE CORPORATION COMMISSION
JUN 18 1970
CONSERVATION DIVISION
Wichita, Kansas
06-18-1970

(If additional description is necessary, use BACK of this sheet)
Name of Plugging Contractor ISERN DRILLING COMPANY
Address Box 486, Ellinwood, Kansas 67526

STATE OF KANSAS, COUNTY OF BARTON, ss.
W. F. Banks (employee of owner) or (owner or operator) of the above-described well, being first duly sworn on oath, says: That I have knowledge of the facts, statements and matters herein contained and the log of the above-described well as filed and that the same are true and correct. So help me God.

(Signature) W. F. Banks

Box 486, Ellinwood, Kansas 67526
(Address)

SUBSCRIBED AND SWORN to before me this 12th day of June, 19 70

My commission expires February 10, 1971.

George A. Meyer
Notary Public.

W E L L L O G

Lee Phillips Oil Company
VON LINTEL #1, SW NW SW
Section 12-13S-17W
Ellis County, Kansas

ELEVATION: 2014' GL; 2016' DF; 2018' KB.

Figures indicate bottom of formation:

ELEVATION:	2014' GL	0	to	40	rock
	2016' DF			210	shale
	2018' KB			640	shale & shells
				830	sand
PIPE RECORD:				1187	red rock
8 5/8" set at 207'				1280	shale
with 150 sacks cement.				1875	shale & shells
				2310	lime & shale
				2825	shale & lime
ROTARY COMMENCED: 6- 5-70				3284	lime & shale
ROTARY COMPLETED: 6-10-70				3284	Rotary Total Depth

DRY & ABANDONED

TOPS

Anhydrite 1226
Heebner 3246

RECEIVED
STATE CORPORATION COMMISSION
JUN 18 1970
CONSERVATION DIVISION
Wichita, Kansas
06-18-1970

STATE OF KANSAS)
COUNTY OF BARTON) ss

I, W. F. Banks, Drilling Superintendent of Isern Drilling Company, contractor for the above-described well, being first duly sworn on oath, declare: That I have knowledge of the facts, statements and matter herein contained pertaining to the log of the above-described well, as filed, and that the same are true and correct.

W. F. Banks
W. F. Banks, Drilling Supt.

Subscribed and sworn to before me on this 12th day of June, 1970.

George A. Meyer
George A. Meyer, Notary Public

My commission expires: 2-10-71.