

15-051-21906-000


STATE OF KANSAS
STATE CORPORATION COMMISSION

WELL PLUGGING RECORD

Give All Information Completely
Make Required Affidavit
Mail or Deliver Report to
Conservation Division
State Corporation Comm.
245 North Water
Wichita, KS 67202

Ellis County. Sec. 12 Twp. 13 Rge. 17 X/W
Location as "NE/CNW $\frac{1}{4}$ SW $\frac{1}{4}$ " or footage from lines
NE NE NE

Lease Owner D - Oil Operations
Lease Name VonLintel Well No. 1
Office Address Rt. #1, Victoria, KS 67671
Character of Well (Completed as Oil, Gas or Dry Hole)

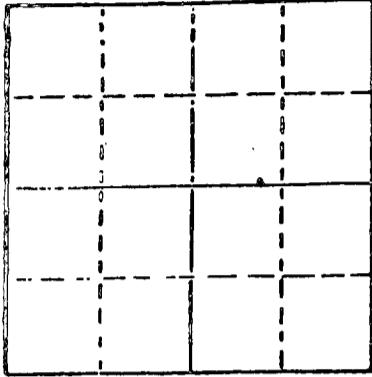

Locate well correctly on above
Section Plot

Dry Hole
Date Well completed 1-31 1980
Application for plugging filed 1-31 1980
Application for plugging approved 1-31 1980
Plugging commenced 1-31 1980
Plugging completed 1-31 1980
Reason for abandonment of well or producing formation

Dry Hole
If a producing well is abandoned, date of last production 19

Was permission obtained from the Conservation Division or its agents before plugging was commenced? yes

Name of Conservation Agent who supervised plugging of this well Marion Schmidt
Producing formation _____ Depth to top _____ Bottom _____ Total Depth of Well 3,573'
Show depth and thickness of all water, oil and gas formations.

OIL, GAS OR WATER RECORDS

CASING RECORD

FORMATION	CONTENT	FROM	TO	SIZE	PUT IN	PULLED OUT
Surface Pipe				8 5/8	209'	0'

Describe in detail the manner in which the well was plugged, indicating where the mud fluid was placed and the method or methods used in introducing it into the hold. If cement or other plugs were used, state the character of same and depth placed, from _____ feet to _____ feet for each plug set.

- 1st plug was set @ 660' w/70 sacks cement
- 2nd plug was set @ 200' w/20 sacks cement
- 3rd plug was set @ 40' w/10 sacks cement

(If additional description is necessary, use BACK of this sheet)

Name of Plugging Contractor Dreiling Oil, Inc.

STATE OF KANSAS COUNTY OF ELLIS

I, Joseph A. Hess, Sec. Treas. of Drlg. Contrc. (employee of owner) or (owner or operator) of the above-described well, being first duly sworn on oath, says: That I have knowledge of the facts, statements, and matters herein contained and the log of the above-described well as filed and that the same are true and correct. So help me God.

(Signature)

JOSEPH A. HESS, HAYS, KS 67601
(Address)

SUBSCRIBED AND SWORN TO before me this 6th day of February, 1980

Cecilia Basgall Notary Public.

My commission expires November 17, 1980

CECILIA BASGALL
NOTARY PUBLIC
Ellis County, Kansas

DREILING OIL, INC.

Victoria, Kansas 67671

15-051-21906-00-00

D - Oil Operations WELL LOG

Company	D - Oil Operations Rt. #1 Victoria, KS 67671	Sec. 12	Twp. 13	Rng. 17
Farm	Von Lintel No. 1	Location	NE NE NE	
Total Depth	3,573'	County	Ellis	
Comm.	1-24-80	Comp.	1-31-80	Elevation: 2017 K. B.
Contractor	Dreiling Oil, Inc. Rt. #1 Victoria, KS 67671		2014	D. F.
			2012	G. R.

Casing Record
209' - 8 5/8"

Cement Record
150 sacks cement

Production:
D & A

Figures Indicate Bottom of Formations

0'	214'	Top Soil, Sand & Shale
214'	780'	Shale
780'	1169'	Sand & Shale
1169'	1210'	Anhydrite
1210'	1855'	Shale
1855'	2045'	Shale & Lime
2045'	2425'	Lime
2425'	2918'	Lime & Shale
2918'	3573'	Lime
3573'	T.D.	

STATE OF KANSAS)

ss

COUNTY OF ELLIS)

I, Joseph A. Hess, Secretary Treasurer of Dreiling Oil, Inc., upon oath states that the above and foregoing is a true and correct copy from the Daily Drilling Report from the VonLintel #1.

Joseph A. Hess
JOSEPH A. HESS

Subscribed and sworn to before me this 6th day of February, 1980.

Cecilia Basgall
Cecilia Basgall Notary Public
CECILIA BASGALL
NOTARY PUBLIC
Ellis County, Kansas

My appointment expires: November 17, 1980.

CA 27-1980