

15-051-00716-00-00

STATE OF KANSAS
STATE CORPORATION COMMISSION

WELL PLUGGING RECORD

Give All Information Completely
Make Required Affidavit
Mail or Deliver Report to:
Conservation Division
State Corporation Commission
800 Biting Building
Wichita, Kansas

This Willis County, Sec. 12 Twp. 13 Rge. 17 (E) (W)

Location as "NE/CNW/SW" or footage from lines. NE SE NW

Lease Owner Glenn R. Nye

Lease Name Lang Well No. #1

Office Address Drawer 30, Hays, Kansas

Character of Well (completed as Oil, Gas or Dry Hole) Dry hole

Date well completed May 16 19 54

Application for plugging filed May 16 19 54

Application for plugging approved May 16 19 54


Plugging commenced May 16 19 54

Plugging completed May 16 19 54

Reason for abandonment of well or producing formation dry hole

If a producing well is abandoned, date of last production 19

Was permission obtained from the Conservation Division or its agents before plugging was commenced?

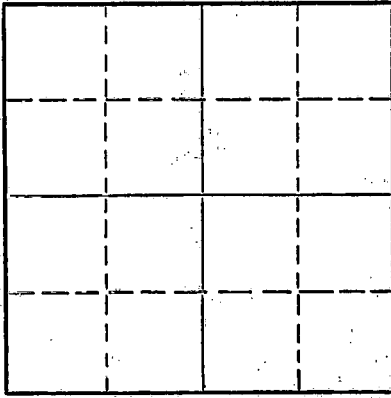

Locate well correctly on above
Section Plat

Name of Conservation Agent who supervised plugging of this well Elton Petty

Producing formation Depth to top Bottom Total Depth of Well 3532 Feet

Show depth and thickness of all water, oil and gas formations.

OIL, GAS OR WATER RECORDS

CASING RECORD

FORMATION	CONTENT	FROM	TO	SIZE	PUT IN	PULLED OUT
				8 5/8"	151'	none

Describe in detail the manner in which the well was plugged, indicating where the mud fluid was placed and the method or methods used in introducing it into the hole. If cement or other plugs were used, state the character of same and depth placed, from feet to feet for each plug set.

Set 1st plug at 180' with 1/2 sack balls and 15 sacks cement thru drill pipe, filled hole with drilling mud to 401, 2nd plug set at 10' with 1/2 sack balls and 10 sacks cement, cemented to bottom of cellar.

(If additional description is necessary, use BACK of this sheet)

Name of Plugging Contractor Nye & Snell Drilling Company

Address Drawer 30, Hays, Kansas

STATE OF Kansas COUNTY OF Willis, ss.
Earl Zuntelbaum (employee of owner) or (owner or operator) of the above-described

well, being first duly sworn on oath, says: That I have knowledge of the facts, statements, and matters herein contained and the log of the above-described well as filed and that the same are true and correct. So help me God.

(Signature) Earl Zuntelbaum

Drawer 30, Hays, Kansas
(Address)

SUBSCRIBED AND SWORN TO before me this 19th day of May 19 54

John L. Johnson
Notary Public.

My commission expires May 7, 1957

24-7368-5 3-53-20M

PLUGGING
FILE SEC 12-13-17W
BOOK PAGE 38-39

05-20-1954

15-051-00776-00-00

Company: Glenn R. Nye
Contractor: Nye & Snell Drilling Company
Commenced: May 6, 1954
Completed: May 16, 1954

Farm: Lang #1
Location: NE SE NW Sec. 12-13-17
Ellis County, Kansas
Casing Record: 8 5/8" set at 151'
Dry and Abandoned
Elevation: 2025 D.F.

(figures below indicate bottoms)

cellar	4	
clay & gumbo	151	
shale & iron streaks	440	
sand	475	
shale & gumbo	700	
sand	960	
red bed	1195	
red bed	1998	
anhydrite	1238	
	1530	
red bed & shale	1820	
shale & lime streaks	1882	
lime & shale	2025	
shale & lime	2195	
lime & shale	2303	
lime	2390	
shale & lime	2395	
shale & lime	2487	
lime & shale	2705	
lime & shale	2855	
shale & lime	2929	
shale & lime	3070	
lime	3120	
shale & lime	3165	
lime & shale	3200	
lime & shale	3270	Heebner 3260 (-1232)
shale & lime	3315	Lansing 3203 (-1280)
lime & shale	3322	
lime	3375	
lime	3425	
lime	3440	
lime	3465	
lime	3515	
lime & shale	3565	Conglomerate 3563 (-1535)
conglomerate	3582	Rotary T.D. 3582 (-1554)

I hereby certify that this is a true and correct log of the above described well as shown by the drilling reports.

NYE & SNELL DRILLING COMPANY

By *Earl Zuttelbaum*

STATE OF KANSAS)
) SS
ELLIS COUNTY)

Subscribed to and sworn to before me, a notary public, in and for said County and State this 19 day of May, 1954.

John L. Weiss
Notary Public

My Commission Expires May 9, 1957

PLUGGING
FILE SEC 12 T 13 R 17W
BOOK PAGE 38 LINE 39

05-20-1954