


Give All Information Completely  
Make Required Affidavit  
Mail or Deliver Report to:  
Conservation Division  
State Corporation Commission  
212 No. Market  
Wichita, Kansas

WELL PLUGGING RECORD

Ellis County, Sec. 12 Twp. 13 Rge. 17 ~~NE~~XXXX(W)  
Location as "NE/CNW/SE/SW" or footage from lines ~~NW SE SE~~ 990' ~~North~~ *990' North*  
Lease Owner Weilert Enterprises  
Lease Name Kuhn Well No. #2  
Office Address Box 652 Hays, Kansas 67601  
Character of Well (completed as Oil, Gas or Dry Hole) Dry Hole  
Date well completed 11-18 19 82  
Application for plugging filed 11-18 19 82  
Application for plugging approved 11-18 19 82  
Plugging commenced 11-18 19 82  
Plugging completed 11-18 19 82  
Reason for abandonment of well or producing formation Dry Hole

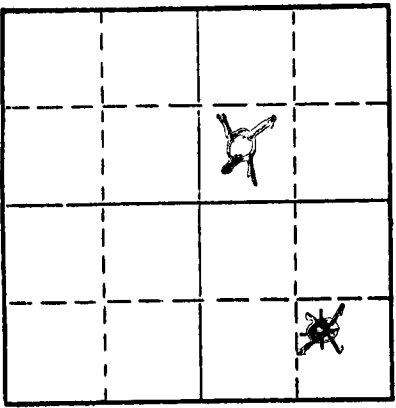

Locate well correctly on above Section Plat

If a producing well is abandoned, date of last production 19  
Was permission obtained from the Conservation Division or its agents before plugging was commenced? Yes

Name of Conservation Agent who supervised plugging of this well Gilbert Scheck  
Producing formation \_\_\_\_\_ Depth to top \_\_\_\_\_ Bottom \_\_\_\_\_ Total Depth of Well 3620 Feet  
Show depth and thickness of all water, oil and gas formations.

OIL, GAS OR WATER RECORDS

CASING RECORD

FORMATION	CONTENT	FROM	TO	SIZE	PUT IN	PULLED OUT
Surface		0	225'	8 5/8"	225'	0

Describe in detail the manner in which the well was plugged, indicating where the mud fluid was placed and the method or methods used in introducing it into the hole. If cement or other plugs were used, state the character of same and depth placed, from \_\_\_\_\_ feet to \_\_\_\_\_ feet for each plug set.



- 1st. Plug set at 3540' with 20 sacks common cement 50-50 Poz 3% Cal Cl 4% Gel
- 2nd. Plug set at 1170' with 20 sacks common cement 50-50 Poz 3% Cal Cl 4% Gel
- 3rd. Plug set at 660' with 80 sacks common cement 50-50 Poz 3% Cal Cl 4% Gel
- 4th. Plug set at 240' with 40 sacks common cement 50-50 Poz 3% Cal Cl 4% Gel
- 5th. Plug set at 40' solid bridge with 10 sacks common cement 50-50 Poz 3% Cal Cl 4% Gel
- 10 sacks in rathole
- Heavy drilling mud between each plug

(If additional description is necessary, use BACK of this sheet)

Name of Plugging Contractor Sun Oilwell Cementing  
Address Hays, Kansas 67601

STATE OF Kansas COUNTY OF Graham ss.  
Jerry M. Helberg (employee of owner) or (owner or operator) of the above-described well, being first duly sworn on oath, says: That I have knowledge of the facts, statements, and matters herein contained and the log of the above-described well as filed and that the same are true and correct. So help me God.  
(Signature) *Jerry M. Helberg*  
Box 32 Morland, Kansas 67650  
(Address)

SUBSCRIBED AND SWORN TO before me this 2nd day of December

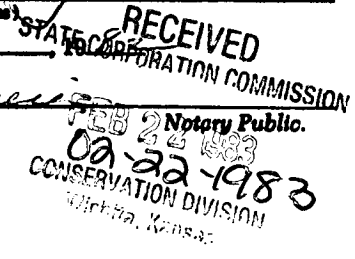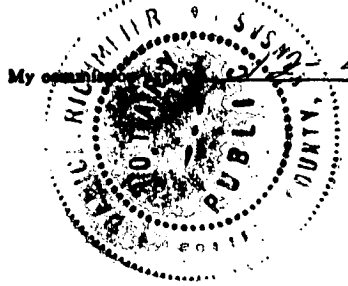

My commission expires 4-83