


STATE OF KANSAS
STATE CORPORATION COMMISSION

Give All Information Completely
Make Required Affidavit
Mail or Deliver Report to:
Conservation Division
State Corporation Commission
212 No. Market
Wichita, Kansas

WELL PLUGGING RECORD

NORTH

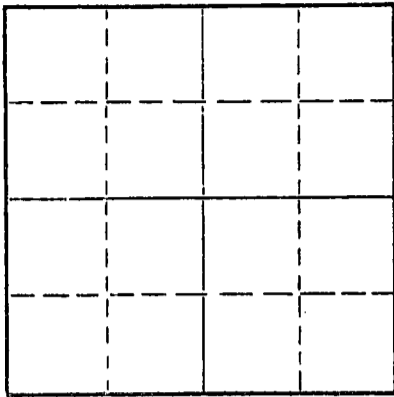

Locate well correctly on above
Section Plat

Ellis County, Sec. 12 Twp. 13 Rge. 17 (E) W (W)
Location as "NE/CNW/SW" or footage from lines SE NE SE
Lease Owner Shields Oil Producers, Inc.
Lease Name Kuhn Well No. 1
Office Address Shields Bldg., Russell, Kansas
Character of Well (completed as Oil, Gas or Dry Hole) Dry hole
Date well completed May 12, 19 70
Application for plugging filed May 12, 19 70
Application for plugging approved May 12, 19 70
Plugging commenced May 12, 19 70
Plugging completed May 12, 19 70
Reason for abandonment of well or producing formation Dry hole

If a producing well is abandoned, date of last production 19
Was permission obtained from the Conservation Division or its agents before plugging was commenced? Yes

Name of Conservation Agent who supervised plugging of this well Leo Massey
Producing formation Depth to top Bottom Total Depth of Well 3,580 Feet
Show depth and thickness of all water, oil and gas formations.

OIL, GAS OR WATER RECORDS

CASING RECORD

FORMATION	CONTENT	FROM	TO	SIZE	PUT IN	PULLED OUT
				8 5/8"	247'	Cmtd. w/150 sax

Describe in detail the manner in which the well was plugged, indicating where the mud fluid was placed and the method or methods used in introducing it into the hole. If cement or other plugs were used, state the character of same and depth placed, from feet to feet for each plug set.

Fill hole w/ heavy mud
Set bridge plug @ 600'
Pump 50 sax cement on plug thru 4 1/2" drill pipe
Fill hole w/ heavy mud
Set bridge plug @ 240'
Pump 25 sax cement on plug thru 4 1/2" drill pipe
Fill hole w/ heavy mud
Set bridge plug @ 40' w/ 1/2 sax hulls on plug
Dump 10 sax cement on plug to cellar

RECEIVED
STATE CORPORATION COMMISSION
JUN 2 1970
CONSERVATION DIVISION
Wichita, Kansas

06-02-1970

(If additional description is necessary, use BACK of this sheet)

Name of Plugging Contractor Shields Drilling Co., Inc.
Address Shields Bldg., Russell, Kansas

STATE OF Kansas, COUNTY OF Russell, ss.
R. J. Shields (employee of owner) or (owner or operator) of the above-described

well, being first duly sworn on oath, says: That I have knowledge of the facts, statements, and matters herein contained and the log of the above-described well as filed and that the same are true and correct. So help me God.

(Signature) R. J. Shields
Shields Bldg., Russell, Kansas
(Address)

SUBSCRIBED AND SWORN TO before me this 25th day of May, 19 70

My commission expires May 26, 1971

Lush Phillips
Notary Public.




Shields 15-051-20623-0000 Russell, Kansas

WELL LOG

Operator: Shields Oil Producers, Inc.
Well: Kuhn #1
Commenced: May 5, 1970
Completed: May 12, 1970
Contractor: Shields Drilling Co., Inc.

Well Description: SE NE SE
Sec. 12-13S-17W
Ellis County, Kansas

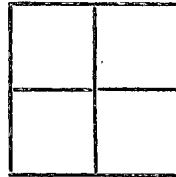

CASING RECORD		
Size	Run	Pulled
8 5/8"	247'	Cmtd. w/ 150 sax

Elevation: 2,017' RB

Treatment:

Production: D & A

Tops: Heebner 3,229'
Toronto 3,250'
Lansing-KC 3,280'
Conglomerate 3,522'

..... Figures Indicate Bottom of Formations

Shale	160'
Shale & sand	520'
Shale, sand & redbed	1,166'
Anhydrite	1,204'
Shale & shells	1,400'
Salt, shale & lime	1,690'
Shale & lime	3,000'
Lime	3,580' RTD

NOTES

DST #1 3,282' - 3,315' Tool open w/ weak blow dying in 5 min.
Recovered 10' mud. IBHP-466#, IFP-38#,
FFP-53#, FBHP-not taken.

DST #2 3,330' - 3,363' Tool open w/ weak blow dying in 14 min.
Recovered 15' mud w/ few oil specks.
IBHP-329#, IFP-45#, FFP-65#,
FBHP-109#/30 min.

RECEIVED
STATE CORPORATION COMMISSION

JUN 2 1970

CONSERVATION DIVISION
Wichita, Kansas

06-02-1970