


STATE OF KANSAS
STATE CORPORATION COMMISSION

WELL PLUGGING RECORD

Give All Information Completely
Make Required Affidavit
Mail or Deliver Report to
Conservation Division
State Corporation Comm.
245 North Water
Wichita, KS 67202

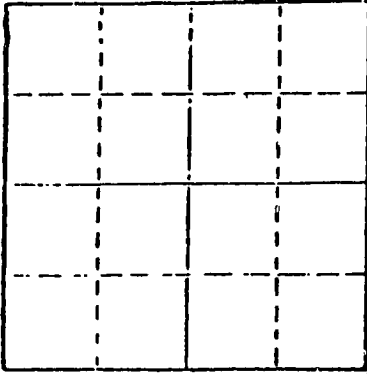

Locate well correctly on above
Section Plat

Ellis County. Sec. 19 Twp. 13 Rge. 17 E/W
Location as "NE/CNW 1/4 SW 1/4" or footage from lines _____
NW SW SW

Lease Owner Ernst & Steidle Operations

Lease Name Staab Well No. 1

Office Address 1025 Main, Russell, KS 67665

Character of Well (Completed as Oil, Gas or Dry Hole) _____
Dry Hole

Date Well completed _____ 11-21 1980

Application for plugging filed _____ 11-21 1980

Application for plugging approved _____ 11-21 1980

Flugging commenced _____ 11-21 1980

Plugging completed _____ 11-22 1980

Reason for abandonment of well or producing formation _____
Dry Hole

If a producing well is abandoned, date of last production _____
19 _____

Was permission obtained from the Conservation Division or
its agents before plugging was commenced? Yes

Name of Conservation Agent who supervised plugging of this well Marion Schmidt

Producing formation _____ Depth to top _____ Bottom _____ Total Depth of Well _____

Show depth and thickness of all water, oil and gas formations.

OIL, GAS OR WATER RECORDS

CASING RECORD

FORMATION	CONTENT	FROM	TO	SIZE	PUT IN	PULLED OUT
				8-5/8	257	-0-

Describe in detail the manner in which the well was plugged, indicating where the mud fluid was placed and the method or methods used in introducing it into the hold. If cement or other plugs were used, state the character of same and depth placed, from _____ feet to _____ feet for each plug set.

Mud laden fluid 3720-257'
70 sks cement @ 720'
25 sks cement @ 240'
10 sks cement @ 40'
5 sks cement in rat hole

(If additional description is necessary, use BACK of this sheet)

Name of Plugging Contractor Emphasis Oil Operations

STATE OF Kansas COUNTY OF Russell, ss.
Joe K. Branum (employee of owner) or (owner or operator)

of the above-described well, being first duly sworn on oath, says: That I have knowledge of the facts, statements, and matters herein contained and the log of the above-described well as filed and that the same are true and correct. So help me God.


(Signature) Joe K. Branum

Box 506, Russell, KS 67665

(Address)

SUBSCRIBED AND SWORN TO before me this 24th day of November, 19 80

My commission expires April 29, 1984

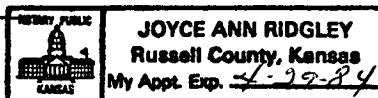

Joyce Ann Ridgley
Notary Public.

EMPHASIS OIL OPERATIONS

P.O. Box 506
 Russell, Kansas 67665

DRILLERS LOG

OPERATOR: Ernst & Steinle Operations
 1025 Main
 Russell, Kansas 67665

CONTRACTOR: Emphasis Oil Operations
 P.O. Box 506
 Russell, Kansas 67665

LEASE: Stabb WELL: #1

LOCATION: NW SW SW
 Section 19-13-17
 Ellis County, Kansas

Total Depth: 3720'
 Commenced: 11-13-80
 Casing: 8-5/8" @ 257'

Elevation:
 Completed: 11-22-80
 Status: Dry Hole

DEPTHS & FORMATIONS

(All Measurements from K.B.)

Soil & post rock	135	Shale & lime	2690
Sand & shale	1363	Lime & shale	3390
Anhydrite	1407	Lime (R.T.D.)	3720

STATE OF KANSAS)
 ss
 COUNTY OF RUSSELL)


11-25-1980

I, Joe K. Branum, of Emphasis Oil Operations, state that the above and foregoing is a true and correct log of the above captioned well.

Joe K. Branum
 Joe K. Branum

Subscribed and sworn to before me this 24th day of November, 1980.

My Commission Expires: April 29, 1984.

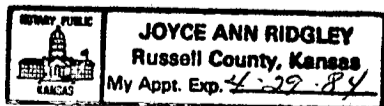

Joyce Ann Ridgley
 Notary Public