


WELL PLUGGING RECORD

Give All Information Completely  
Make Required Affidavit  
Mail or Deliver Report to:  
Conservation Division  
State Corporation Commission  
800 Bittling Building  
Wichita, Kansas

NORTH

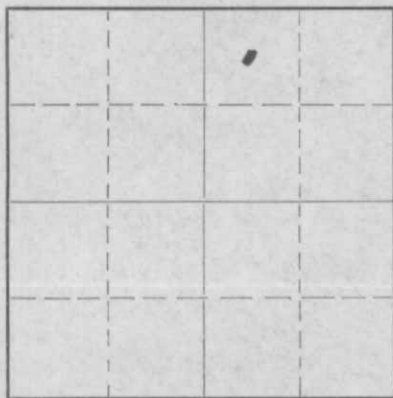

Locate well correctly on above  
Section Plat

County. Sec. 19 Twp. 13 Rge. 17 (E).....(W)  
Location as "NE/CNW $\frac{1}{4}$ SW $\frac{1}{4}$ " or footage from lines 990' from East line, 330' from North line  
Lease Owner Dwight Sutherland  
Lease Name J. Staab Well No. 1  
Office Address 4000 Main Street, Kansas City, Mo.  
Character of Well (completed as Oil, Gas or Dry Hole) Dry hole  
Date well completed..... December 7 ..... 19 50  
Application for plugging filed..... December 7 ..... 19 50  
Application for plugging approved..... December 7 ..... 19 50  
Plugging commenced..... December 7 ..... 19 50  
Plugging completed..... December 7 ..... 19 50  
Reason for abandonment of well or producing formation..... dry hole

If a producing well is abandoned, date of last production..... 19  
Was permission obtained from the Conservation Division or its agents before plugging was commenced?..... Yes

Name of Conservation Agent who supervised plugging of this well..... Eldon Petty  
Producing formation..... Depth to top..... Bottom..... Total Depth of Well..... 3530' Feet  
Show depth and thickness of all water, oil and gas formations.

OIL, GAS OR WATER RECORDS

CASING RECORD

Formation	Content	From	To	Size	Put In	Pulled Out
				<u>8 5/8"</u>	<u>270'</u>	<u>Cemented in</u>

Describe in detail the manner in which the well was plugged, indicating where the mud fluid was placed and the method or methods used in introducing it into the hole. If cement or other plugs were used, state the character of same and depth placed, from.....feet to.....feet for each plug set.

15 sacks of cement was mixed and pumped through drill pipe after cement plug was pushed down to a depth of 240'. Ten sacks of cement was mixed and placed on top of cement plug at 40' to the bottom of cellar.

(If additional description is necessary, use BACK of this sheet)

Correspondence regarding this well should be addressed to..... Glenn R. Nye Drilling Company  
Address..... Box 465, Hays, Kansas

STATE OF Kansas....., COUNTY OF Ellis....., ss.  
Glenn R. Nye.....(employee of owner) or (owner or operator) of the above-described well, being first duly sworn on oath, says: That I have knowledge of the facts, statements, and matters herein contained and the log of the above-described well as filed and that the same are true and correct. So help me God.

(Signature) Glenn R. Nye  
Box 465, Hays, Kansas  
(Address)

SUBSCRIBED AND SWORN to before me this 12th day of December, 19 50.

My commission expires May 9, 1953

22-5133-s 9-48-10M

PLUGGING  
FILE SEC 19 T 13 R 17 W  
BOOK PAGE 47 LINE 37

RECEIVED  
STATE CORPORATION COMMISSION  
DEC 14 1950  
CONSERVATION DIVISION  
Wichita, Kansas  
Notary Public.

Company: Dwight Sutherland et al  
Contractor: Glenn R. Nye Drilling Company  
Commenced: November 25, 1950  
Completed: December 7, 1950

Farm: J. Staab No. 1  
Location: NE 1/4 Sec. 19-13-17  
Ellis County, Kansas  
Casing Record: 8 5/8" set at 270'

(Figures below indicate bottoms)

surface clay	50		
shale & clay	190		
shale & sand	220		
shale & shells	235		
blue shale	270		
blue shale	450		
sand	495		
blue shale	550		
blue shale	620		
red bed	650		
Dokota sand	940		
red bed & shale	1035		
red bed & shale	1325		
red bed & shale	1338		
anhydrite	1370		
shale & shells	1550		
shale & shells	1925		
shale & shells	2005		
shale & lime shells	2080		
lime & shale	2140		
lime & shale	2280		
lime & shale	2345		
lime & shale	2445		
lime & shale	2500		
lime & shale	2525		
shale & shells	2575		
shale & lime	2700		
shale & lime	2775		
shale & lime	2840		
shale & lime	2900		
shale & lime	2965		
shale & lime	3070		
shale & lime	3100		
lime & shale	3138		
lime & shale	3195		
lime & shale	3248		
lime & shale	3280		
lime	3295		
lime	3310		
lime	3360	Top Heetner	3366'
heetner shale	3375		
lime	3392		
lime	3442	Top K.C. Lansing	3410'
lime	3470		
lime	3485		
lime	3511		
lime	3513		
lime	3530	T. D.	

I hereby certify that this is a true and correct log of the above described well as shown by the drilling reports.

Glenn R. Nye Drilling Company

By Glenn R. Nye  
STATE COMMISSIONER  
RECEIVED  
NOV 14 1950  
CONV. DIV. 1950  
ELLIS COUNTY, KANSAS

State of Kansas )  
                          ) SS  
Ellis County      )

Subscribed and sworn to before me, a Notary Public, in and for Ellis County and State this 12 day of Dec., 1950.

John L. Quinn  
Notary Public

My Commission Expires May 9, 1953

PLU  
FILE SEC 19-13-17W  
BOOK PAGE 47 LINE 37