

FOR KCC USE:

EFFECTIVE DATE: 5-19-96

DISTRICT # 4  
SEA? Yes  No

FORM C-1 7/9

FORM MUST BE TYPE

FORM MUST BE SIGNED

ALL BLANKS MUST BE FILLED

State of Kansas  
NOTICE OF INTENTION TO DRILL

Must be approved by the K.C.C. five (5) days prior to commencing well

Expected Spud Date: May 17, 1996  
month day year

Spot: NW SW NE Sec 4 Twp 10 S Rg 32 East  
X West

OPERATOR: License # 06113  
Name: Landmark Energy Expl. Inc./Vess Oil Corp.  
Address: 1861 N. Rock Road, Suite 205  
City/State/Zip: Wichita, KS 67206  
Contact Person: Jeff Wood  
Phone: (316) 683-8080

1650 feet from South / North line of Section  
2310 feet from East / West line of Section  
IS SECTION X REGULAR IRREGULAR

(NOTE: Locate well on the Section Plat on Reverse Side)

County: Thomas  
Lease Name: OHL Southwest Well #: 1-4  
Field Name: unnamed

CONTRACTOR: License # 6039  
Name: L. D. Drilling, Inc.

Is this a Prorated/Spaced Field? yes X no

Target Formation(s): Lansing  
Nearest lease or unit boundary: 330'

Well Drilled For: Well Class: Type Equipment:  
X Oil ... Enh Rec ... Infield X Mud Rotary  
... Gas ... Storage ... Pool Ext. ... Air Rotary  
... OUVV ... Disposal X Wildcat ... Cable  
... Seismic; ... # of Holes ... Other

Ground Surface Elevation: 3092 feet MSL  
Water well within one-quarter mile: X yes X no

Public water supply well within one mile: yes X no  
Depth to bottom of fresh water: 260'  
Depth to bottom of usable water: 1740'

If OUVV: old well information as follows:  
Operator:  
Well Name:  
Comp. Date: Old Total Depth:

Surface Pipe by Alternate: 1 X 2  
Length of Surface Pipe Planned to be set: 315'

Length of Conductor pipe required: None  
Projected Total Depth: 4700'

Formation at Total Depth: Mississippi  
Water Source for Drilling Operations:

Directional, Deviated or Horizontal wellbore? yes X no  
If yes, true vertical depth:  
Bottom Hole Location:

DWR Permit #: well farm pond X other  
Will Cores Be Taken? yes X no  
If yes, proposed zone:

AFFIDAVIT

RECEIVED

KANSAS CORPORATION COMMISSION WITH K.S.A. 55-

The undersigned hereby affirms that the drilling, completion and eventual plugging  
101, et. seq.  
It is agreed that the following minimum requirements will be met:

MAY 14 1996

CONSERVATION DIVISION  
WICHITA, KS

1. Notify the appropriate district office prior to spudding of well;
2. A copy of the approved notice of intent to drill shall be posted on each drilling rig;
3. The minimum amount of surface pipe as specified below shall be set by circulating cement to the top; in all cases surface pipe shall be set through all unconsolidated materials plus a minimum of 20 feet into the underlying formation;
4. If the well is dry hole, an agreement between the operator and the district office on plug length and placement is necessary prior to plugging;
5. The appropriate district office will be notified before well is either plugged or production casing is cemented in;
6. IF AN ALTERNATE IS COMPLETED, PRODUCTION PIPE SHALL BE CEMENTED FROM BELOW ANY USABLE WATER TO SURFACE WITHIN 120 DAYS OF SPUD DATE. IN ALL CASES, NOTIFY DISTRICT OFFICE PRIOR TO ANY CEMENTING.

I hereby certify that the statements made herein are true and to the best of my knowledge and belief.

Date: 5/13/96 Signature of Operator or Agent: Laura Engler Title: Exec. Assistant

FOR KCC USE:  
 API # 15- 193-206490000  
 Conductor pipe required NONE feet  
 Minimum surface pipe required 310' feet per Alt. X 2  
 Approved by: JK 5-14-96  
 This authorization expires: 11-14-96  
 (This authorization void if drilling not started within 6 months of effective date.)  
 Spud date: Agent:

REMEMBER TO:

- File Drill Pit Application (form COP-1) with Intent to Drill;
- File Completion Form ACO-1 within 120 days of spud date;
- File acreage attribution plat according to field proration orders;
- Notify appropriate district office 48 hours prior to workover or re-entry;
- Submit plugging report (CP-4) after plugging is completed;
- Obtain written approval before disposing or injecting salt water.

Mail to: Conservation Division, 200 Colorado Derby Building, 202 W. First St., Wichita, Kansas 67202-1286.

4  
10  
32W

IN ALL CASES PLOT THE INTENDED WELL ON THE PLAT BELOW

PLAT OF ACREAGE ATTRIBUTABLE TO A WELL IN A PRORATED OR SPACED FIELD

If the intended well is in a prorated or spaced field, please fully complete this side of the form. If the intended well is in a prorated or spaced field complete the plat below showing that the well will be properly located in relationship to other wells producing from the common source of supply. Please show all the wells within 1 mile of the boundaries of the proposed acreage attribution unit for gas wells and within 1/2 mile of the boundaries of the proposed acreage attribution unit for oil wells.

API NO. 15- \_\_\_\_\_  
 OPERATOR \_\_\_\_\_  
 LEASE \_\_\_\_\_  
 WELL NUMBER \_\_\_\_\_  
 FIELD \_\_\_\_\_



LOCATION OF WELL: COUNTY \_\_\_\_\_  
 \_\_\_\_\_ feet from south/north line of section  
 \_\_\_\_\_ feet from east/west line of section  
 SECTION \_\_\_\_\_ TWP \_\_\_\_\_ RG \_\_\_\_\_

NUMBER OF ACRES ATTRIBUTABLE TO WELL \_\_\_\_\_  
 QTR/QTR/QTR OF ACREAGE \_\_\_\_\_

IS SECTION \_\_\_\_\_ REGULAR or \_\_\_\_\_ IRREGULAR  
IF SECTION IS IRREGULAR, LOCATE WELL FROM NEAREST CORNER BOUNDARY.

Section corner used: \_\_\_\_\_ NE \_\_\_\_\_ NW \_\_\_\_\_ SE \_\_\_\_\_ SW  
PLAT

(Show location of the well and shade attributable acreage for prorated or spaced wells.)  
 (Show footage to the nearest lease or unit boundary line.)

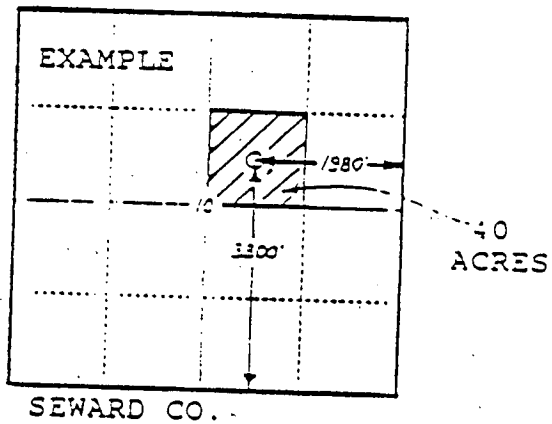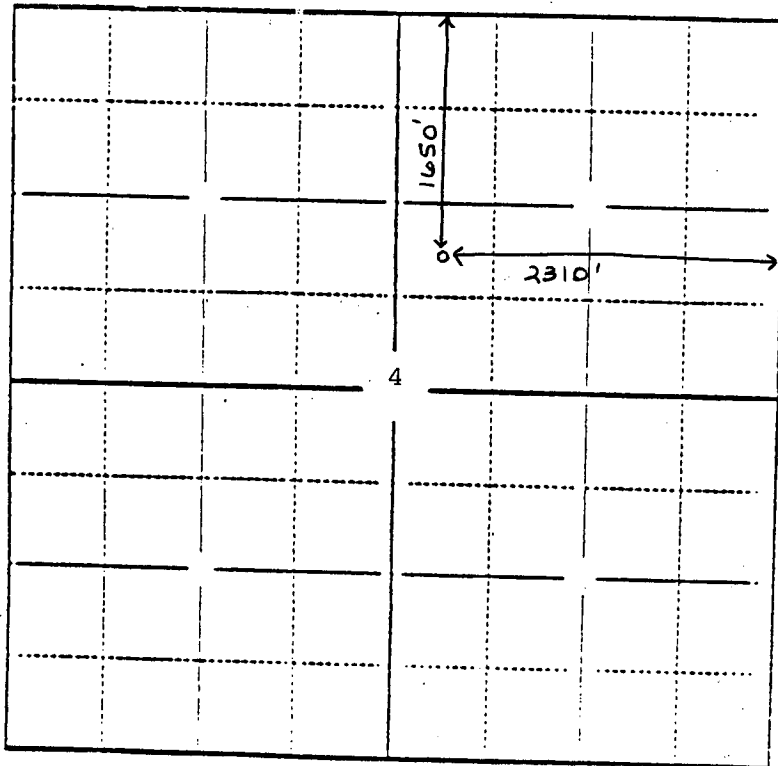

THOMAS CO.

In plotting the proposed location of the well, you must show:

- 1) The manner in which you are using the depicted plat by identifying section lines, i.e. 1 section, 1 section with 8 surrounding sections, 4 sections, etc.;
- 2) the distance of the proposed drilling location from the section's south/north and east/west lines; and
- 3) the distance to the nearest lease or unit boundary line.