


Give All Information Completely
Make Required Affidavit
Mail or Deliver Report to:
Conservation Division
State Corporation Commission
212 North Market, Insurance Bldg.
Wichita, Kansas

WELL PLUGGING RECORD

Ellis County, Sec. 23 Twp. 13S Rge. 17W (E) (W)

Location as "NE/CNW/SW" or footage from lines NW SW NW
Lease Owner ALPINE OIL & ROYALTY CO., INC.
Lease Name ANTON KUHN Well No. 6
Office Address 800 Bitting Building, Wichita, Kansas
Character of Well (completed as Oil, Gas or Dry Hole) oil well
Date well completed September 25, 1957 19
Application for plugging filed October 12, 1961 19
Application for plugging approved October 12, 1961 19
Plugging commenced October 14, 1961 19
Plugging completed October 17, 1961 19
Reason for abandonment of well or producing formation non-productive in commercial quantities
If a producing well is abandoned, date of last production October 6 1961
Was permission obtained from the Conservation Division or its agents before plugging was commenced? yes

NORTH

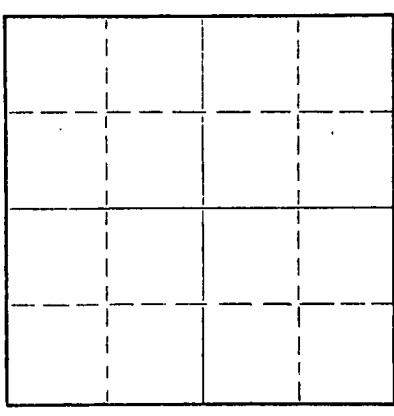

Locate well correctly on above Section Plat

Name of Conservation Agent who supervised plugging of this well Eldon Petty
Producing formation Arbuckle Depth to top 3488 Bottom _____ Total Depth of Well 3502 Feet
Show depth and thickness of all water, oil and gas formations.

OIL, GAS OR WATER RECORDS

CASING RECORD

FORMATION	CONTENT	FROM	TO	SIZE	PUT IN	PULLED OUT
				8 5/8"	153	Cemented
				4 1/2"	3490	2739 feet

Describe in detail the manner in which the well was plugged, indicating where the mud fluid was placed and the method or methods used in introducing it into the hole. If cement or other plugs were used, state the character of same and depth placed, from _____ feet to _____ feet for each plug set.

Cemented bottom of hole - pumped 14 sacks of mud and 20 sacks of cement at 500 feet - pumped 20 sacks of cement at 160 feet and 10 sacks of cement at 30 feet to base of cellar

FILED
STATE CORPORATION COMMISSION
NOV 2 1961
11-02-1961
CONSERVATION DIVISION
Wichita, Kansas

(If additional description is necessary, use BACK of this sheet)
Name of Plugging Contractor Glenn and Smith Pipe Pulling Company
Address Box 114 - Ellinwood, Kansas

STATE OF Kansas, COUNTY OF Sedgwick, ss.
Thomas M. McCaul (employee of owner) or (owner or operator) of the above-described well, being first duly sworn on oath, says: That I have knowledge of the facts, statements, and matters herein contained and the log of the above-described well as filed and that the same are true and correct. So help me God.

(Signature) Thomas M. McCaul
800 Bitting Building, Wichita, Ks.
(Address)

SUBSCRIBED AND SWORN to before me this 1st day of November, 19 61

My commission expires August 10, 1965
Virginia Marshall Notary Public.



14

15-051-02747-00-00

WELL LOG

ALPINE OIL & ROYALTY CO., INC.

Commenced: Sept. 15, 1957

Contractor: Quaker Drilling Co., Inc.

Completed: Sept. 25, 1957

Anton Kuhn No. 6
NW SW NW Sec. 23-13S-17W
Ellis County, Kansas

Elevation: 1971 K. B.

Casing Record:

Set 8 5/8 inch casing at 153 feet with 160 sacks pozmix
Set 4 1/2 inch casing at 3490 feet with 150 sacks pozmix

(Figures Indicate the Bottom of the Formations)

<u>FORMATION</u>	<u>DEPTH</u>	<u>FORMATION TOPS</u>	
Shale and Shells	153	Anhydrite	1151
Shale	290	Heebner	3196 -1225
Shale & Streaks of Sand	670	Toronto	3216 -1245
Sand	815	Lansing	3241 -1270
Shale & Shells	980	Base of Kansas City	3470 -1499
Red Bed	1151	Arbuckle	3488 -1517
Anhydrite	1196	Rotary Total	
Lime & Shale	1585	Depth	3490 -1519
Shale & Shells	1850		
Lime & Shale	1965		
Sandy Lime & Shale	2120		
Shale & Lime	3300		
Lime	3350		
Shale & Lime	3410		
Lime	3490		

RECEIVED
STATE CORPORATION COMMISSION
NOV 2 1961
11-02-1961
CONSERVATION DIVISION
Wichita, Kansas

We hereby certify the foregoing to be a true and correct copy of the Driller's Log on the well drilled in the NW SW NW of Section 23, Township 13 South, Range 17 West Ellis County, Kansas.

QUAKER DRILLING CO., INC.

By: Thomas M. McCaul
Thomas M. McCaul, President

SUBSCRIBED AND SWORN to before me a Notary Public in and for Sedgwick County, Kansas this 1st day of October, 1957.

Virginia Mundell
Virginia Mundell, Notary Public

MY COMMISSION EXPIRES:
August 10, 1961