


WELL PLUGGING RECORD

Give All Information Completely
Make Required Affidavit
Mail or Deliver Report to:
Conservation Division
State Corporation Commission
212 North Market, Insurance Bldg.
Wichita, Kansas

Ellis County. Sec. 23 Twp. 13S Rge. 17W (E) (W)
Location as "NE/CNW&SW" or footage from lines NW SE NW NW
Lease Owner ALPINE OIL & ROYALTY CO., INC. et al
Lease Name Anton Kuhn Well No. 7
Office Address 800 Bitting Building, Wichita, Kansas
Character of Well (completed as Oil, Gas or Dry Hole) oil well
Date well completed February 4, 1958 19
Application for plugging filed February 4, 1959 19
Application for plugging approved X February 4, 1959 19
Plugging commenced February 9, 1959 19
Plugging completed February 12, 1959 19
Reason for abandonment of well or producing formation non-productive in commercial quantities
If a producing well is abandoned, date of last production January 31, 1959 19 X
Was permission obtained from the Conservation Division or its agents before plugging was commenced? Yes

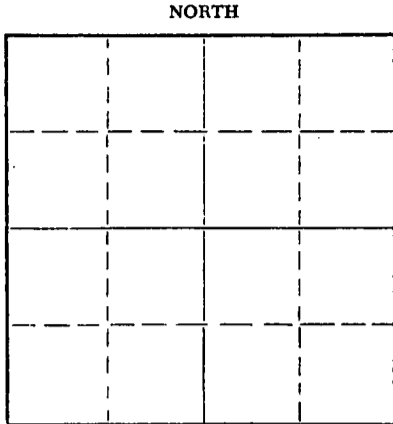

Locate well correctly on above Section Plat

Name of Conservation Agent who supervised plugging of this well Eldon Petty
Producing formation Lansing-KC Depth to top 3270 Bottom 3502 Total Depth of Well 3600 Feet
Show depth and thickness of all water, oil and gas formations.

OIL, GAS OR WATER RECORDS

CASING RECORD

FORMATION	CONTENT	FROM	TO	SIZE	PUT IN	PULLED OUT
				8 5/8"	150'	Cemented
				4 1/2"	3600'	2812'

Describe in detail the manner in which the well was plugged, indicating where the mud fluid was placed and the method or methods used in introducing it into the hole. If cement or other plugs were used, state the character of same and depth placed, from _____ feet to _____ feet for each plug set.

Filled with sand from 3590 to 3330 feet - ran 4 sacks cement from 3330 feet to 3282 feet - pumped 27 sacks mud at 480 feet - and 25 sacks cement - pumped 20 sacks cement at 180 feet - bailed out mud to 30 feet and ran 10 sacks cement to base of cellar

RECEIVED
STATE CORPORATION COMMISSION

FEB 24 1959
02-24-1959
CONSERVATION DIVISION
Wichita, Kansas

(If additional description is necessary, use BACK of this sheet)
Name of Plugging Contractor Glenn & Smith Pipe Pulling Company
Address Box 114 - Ellinwood, Kansas

STATE OF Kansas, COUNTY OF Sedgwick, ss.
Thomas M. McCaul (employee of owner) or (owner or operator) of the above-described well, being first duly sworn on oath, says: That I have knowledge of the facts, statements, and matters herein contained and the log of the above-described well as filed and that the same are true and correct. So help me God.

(Signature) Thomas M. McCaul
800 Bitting Building, Wichita, Kansas (Address)

SUBSCRIBED AND SWORN TO before me this 17th day of February, 19 59
Eugenia M. Muddell Notary Public.

My commission expires August 10, 1961

PLUGGING
FILE SEC. 23 T. 13 R. 17W
BOOK PAGE 20 LINE 21

15-051-02748-00-00

WELL LOG

ALPINE OIL & ROYALTY CO., INC.

Commenced: January 26, 1958

Contractor: Quaker Drilling Co., Inc.

Completed: February 4, 1958

Anton Kuhn No. 7
NW SE NW Sec. 23-13S-17W
Ellis County, Kansas

Elevation: 2000 KB

Casing Record

Set 8 5/8 inch casing at 150 feet with 150 sacks pozmix
Set 4 1/2 inch casing at 3600 feet with 150 sacks pozmix

(Figures Indicate the Bottom of the Formations)

<u>FORMATION</u>	<u>DEPTH</u>	<u>FORMATION TOPS</u>
Shale & Shells	290	Anhydrite 1177 / 823
Sand	455	Heebner 3221 -1221
Sand & 60' streaks of shale	630	Langing 3270 -1270
Sand	830	Conglomerate 3510 -1510
Red Bed	1177	Rotary Total Depth 3600 -1600
Anhydrite	1209	
Shale and Shells	1875	
Shale and Lime	2180	
Hard Sandy Lime	2265	
Lime and Shale	2343	
Shale	2540	
Lime and Shale	2650	
Shale and Lime	2780	
Shale	2945	
Shale and Lime	3115	
Shale	3173	
Shale and Lime	3415	
Lime	3450	
Shale and Lime	3600	

RECEIVED
STATE CORPORATION COMMISSION
FEB 24 1958
CONSERVATION DIVISION
Wichita, Kansas
02-24-1958

We hereby certify the foregoing to be a true and correct copy of the Driller's Log of the well drilled in the NW SE NW of Section 23, Township 13 South, Range 17 West, Ellis County, Kansas.

QUAKER DRILLING CO., INC.

By: Thomas M. McCaul
Thomas M. McCaul, President

SUBSCRIBED AND SWORN to before me a Notary Public in and for Sedgwick County, Kansas this 5th day of February, 1958.

Virginia Mundell
Virginia Mundell, Notary Public

MY COMMISSION EXPIRES:
August 10, 1961

PLUGGING
FILE SEC. 23 T. 13 R. 17W
BOOK PAGE 20 LINE 21