


Give All Information Completely
Make Required Affidavit
Mail or Deliver Report to:
Conservation Division
State Corporation Commission
212 North Market, Insurance Bldg.
Wichita, Kansas

WELL PLUGGING RECORD

Clark County, Sec. 2 Twp. 34S Rge. 22W (E) (W)

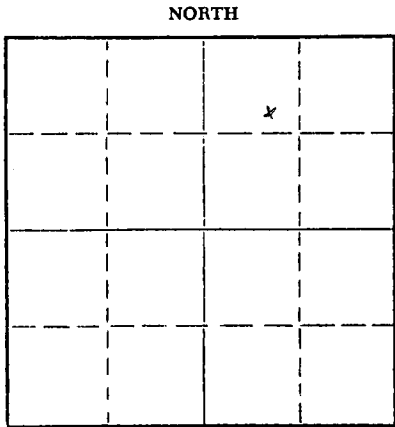

Locate well correctly on above Section Plat

Location as "NE/CNW/SW" or footage from lines _____
Lease Owner Ashland Oil & Refining Company
Lease Name McMinimy Well No. 1
Office Address 720 NW 50th Street, Oklahoma City, Oklahoma
Character of Well (completed as Oil, Gas or Dry Hole) Dry hole
Date well completed January 28 1961
Application for plugging filed January 28 1961
Application for plugging approved January 28 1961
Plugging commenced January 28 1961
Plugging completed January 28 1961
Reason for abandonment of well or producing formation Dry hole

If a producing well is abandoned, date of last production _____ 19____
Was permission obtained from the Conservation Division or its agents before plugging was commenced? Yes

Name of Conservation Agent who supervised plugging of this well W. L. MacKamp
Producing formation None Depth to top _____ Bottom _____ Total Depth of Well 5490' Feet
Show depth and thickness of all water, oil and gas formations.

OIL, GAS OR WATER RECORDS

CASING RECORD

FORMATION	CONTENT	FROM	TO	SIZE	PUT IN	PULLED OUT
Surface						
8 5/8 w/596'						
Cement w/500 sacks						
1-13-61						

Describe in detail the manner in which the well was plugged, indicating where the mud fluid was placed and the method or methods used in introducing it into the hole. If cement or other plugs were used, state the character of same and depth placed, from _____ feet to _____ feet for each plug set.
Rubber plug down w/drill pipe, spotted 25 sacks at 547', filled hole w/mud; another at 35' cemented w/10 sacks.

RCUD
02-03-61

(If additional description is necessary, use BACK of this sheet)
Name of Plugging Contractor B. J. Service #P 70754
Address Woodward, Oklahoma

STATE OF Kansas, COUNTY OF Clark, ss.
K. G. Calvery (employee of owner) or (~~owner or operator~~) of the above-described well, being first duly sworn on oath, says: That I have knowledge of the facts, statements, and matters herein contained and the log of the above-described well as filed and that the same are true and correct. So help me God!

(Signature) K. G. Calvery
720 NW 50th Street, Oklahoma City, Oklahoma
(Address)

SUBSCRIBED AND SWORN TO before me this 2nd day of February, 1961

My commission expires 11-3-63 Luth Reagan Notary Public.



R —

McMINIMY #1
SE NW NE Sec. 2-34S-22W
Clark County, Kansas

Date Comm: 1-9-61
Date Comp: 1-28-61

FORMATION RECORD

0 - 1758	Shale & shells
1758 - 3122	Lime & shale
3122 - 3207	Shale, sand & lime
3207 - 3296	Lime & shale
3296 - 3523	Lime, shale & chalk
3523 - 3850	Lime & shale
3850 - 3865	Lime
3865 - 4186	Lime & shale
4186 - 4300	Lime & shale streaks
4300 - 4478	Lime & shale
4478 - 4829	Lime
4829 - 4919	Lime w/chert streaks
4919 - 4985	Lime
4985 - 5097	Lime & chert
5097 - 5322	Lime
5322 - 5383	Shale
5383 - 5490	Lime
5490	T.D.

CASING RECORD

- 1-13-61 Ran 19 jts. 8 5/8" 24# J-55 STC. Ran 585' set @ 596 K.B.,
cem. w/500 sacks Diamix. Plug down @ 11:30 a.m. No returns.
Temperature survey showed top of cem at 135'.
- 1-28-61 Plugged dry hole by spotting 25 sacks cem. @ 547', and top of
hole with 10 sacks at 35'.

RECEIVED
3022 5 1966
CORRELATION DIVISION
Wichita, Kansas