


WELL PLUGGING RECORD

Give All Information Completely  
Make Required Affidavit  
Mail or Deliver Report to:  
Conservation Division  
State Corporation Commission  
211 No. Broadway  
Wichita, Kansas

Ellis County. Sec. 36 Twp. 13 Rge. 7E 17 (W)  
Location as "NE/CNW/SW" or footage from lines SW SE SE  
Lease Owner Triangle Drilling, Inc.  
Lease Name Braun Well No. 1  
Office Address Box 287 Russell, Kansas  
Character of Well (completed as Oil, Gas or Dry Hole) Dry hole  
Date well completed March 8 19 59  
Application for plugging filed March 11, 1959 19 59  
Application for plugging approved \_\_\_\_\_ 19 \_\_\_\_  
Plugging commenced 3:45 am March 8 19 59  
Plugging completed 10 a.m. " " 19 59  
Reason for abandonment of well or producing formation \_\_\_\_\_  
dry hole

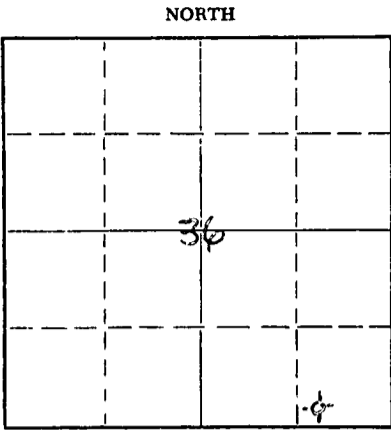

Locate well correctly on above  
Section Plat

If a producing well is abandoned, date of last production \_\_\_\_\_ 19 \_\_\_\_  
Was permission obtained from the Conservation Division or its agents before plugging was commenced? yes

Name of Conservation Agent who supervised plugging of this well Mr. Eldon Petty  
Producing formation \_\_\_\_\_ Depth to top \_\_\_\_\_ Bottom \_\_\_\_\_ Total Depth of Well 3604 Feet  
Show depth and thickness of all water, oil and gas formations.

OIL, GAS OR WATER RECORDS

CASING RECORD

FORMATION	CONTENT	FROM	TO	SIZE	PUT IN	PULLED OUT
				8 5/8"	200'	200'

Describe in detail the manner in which the well was plugged, indicating where the mud fluid was placed and the method or methods used in introducing it into the hole. If cement or other plugs were used, state the character of same and depth placed, from \_\_\_\_\_ feet to \_\_\_\_\_ feet for each plug set.  
Bottom plug set at 480', 20 sacks of cement, Second plug at 180', 15 sacks of cement, top plug at 40' with 1/3 sack of hulls and 10 sacks of cement.

(If additional description is necessary, use BACK of this sheet)

Name of Plugging Contractor Same  
Address \_\_\_\_\_

STATE OF Kansas COUNTY OF Barton, ss.  
Donald D. Vaughan (employee of owner) or (~~owner or operator~~) of the above-described well, being first duly sworn on oath, says: That I have knowledge of the facts, statements, and matters herein contained and the log of the above-described well as filed and that the same are true and correct. So help me God.

(Signature) Donald D. Vaughan  
Box 619 Great Bend, Kansas  
(Address)

SUBSCRIBED AND SWORN TO before me this 10th day of March 19 59

Dean E. Cooley  
Dean E. Cooley Notary Public.

My commission expires April 29, 1961

PLUGGING  
FILE SEC. 36 T. 13 R. 17  
BOOK PAGE 23 LINE 30

RECEIVED  
STATE CORPORATION COMMISSION  
MARCH 14 1959  
CONSERVATION DIVISION  
Wichita, Kansas

WELL LOG

COMPANY Triangle Drilling, Inc.  
 CONTRACTOR Triangle Drilling, Inc.  
 FARM #1 Braun  
 LOCATION SW SE SE of 36-13-17W  
 Ellis County, Kansas  
 ELEVATION 1972 KB  
 SURFACE PIPE 8 5/8" cemented at 200' w/155 sacks common  
 PRODUCTION D & A  
 COMMENCED 2-24-59  
 COMPLETED 3-8-59

<u>FORMATION</u>	<u>DEPTH</u>	<u>FORMATION</u>	<u>DEPTH</u>
Surface clay	40	Broken limestone & shale streaks	1865
Shale & shells	200	Broken limestone	2110
Black shale & limestone streaks	250	Sandy limestone (sharp)	2175
Shale & shells	390	Limestone & shale	2285
Sandstone, shale & limestone	580	Limestone	2355
Sandstone (hard streaks)	770	Limestone & shale	2969
Shale & shells	810	Limestone	3241
Red bed	1138	Shale	3251
Anhydrite	1175	Limestone	3502
Shale & shells	1720	Chert Conglomerate	3504
Shale & limestone	1830	Dolomite	3604

FORMATION TOPS

Anhydrite	1138	(/ 834) driller's
Topeka	2969	(- 997)
Heebner	3205	(-1233)
Toronto	3230	(-1258)
Lansing	3251	(-1279)
Chert Conglomerate	3502	(-1530)
Arbuckle	3504	(-1532)
RTD	3604	(-1632)

**RECEIVED**  
 STATE CORPORATION COMMISSION

MAR 14 1959  
 03-14-1959  
 CONSERVATION DIVISION  
 Wichita, Kansas

A F F I D A V I T

STATE OF KANSAS, COUNTY OF BARTON, SS.

I, Donald D. Vaughan, of the TRIANGLE DRILLING, INC., being first duly sworn on oath, state; That I have knowledge of the facts, statements and matters herein contained and that the same are true and correct.

*Donald D. Vaughan*  
 Donald D. Vaughan

Subscribed and sworn to before me this 12<sup>th</sup> day of March, 1959.

My commission expires: April 29, 1961.

*Dean E. Cooley*  
 Dean E. Cooley, Notary Public

**PLUGGING**  
 FILE SEC. 36 T. 13 R. 17  
 BOOK PAGE 23 LINE 30