


WELL PLUGGING RECORD

Give All Information Completely  
Make Required Affidavit  
Mail or Deliver Report to:  
Conservation Division  
State Corporation Commission  
211 No. Broadway  
Wichita, Kansas

Ellis County. Sec. 36 Twp. 13S Rge. (E) 12 (W)  
Location as "NE/CNW/SW" or footage from lines NW NW SW  
Lease Owner Tennessee Gas Transmission Company  
Lease Name Margaret Kuhn Well No. 1  
Office Address P.O. Box 163 - Great Bend, Kansas  
Character of Well (completed as Oil, Gas or Dry Hole) Dry Hole  
Date well completed 9-14 19 57  
Application for plugging filed 10-14 19 57  
Application for plugging approved 9-24 19 57  
Plugging commenced 9-14 19 57  
Plugging completed 9-14 19 57  
Reason for abandonment of well or producing formation ---

NORTH

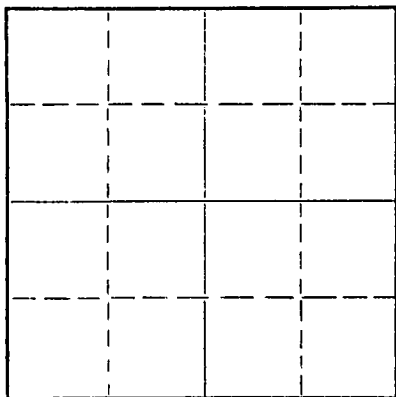

Locate well correctly on above Section Plat

If a producing well is abandoned, date of last production --- 19  
Was permission obtained from the Conservation Division or its agents before plugging was commenced? Yes

Name of Conservation Agent who supervised plugging of this well Eldon Petty  
Producing formation --- Depth to top --- Bottom --- Total Depth of Well 3595 Feet  
Show depth and thickness of all water, oil and gas formations.

OIL, GAS OR WATER RECORDS

CASING RECORD

FORMATION	CONTENT	FROM	TO	SIZE	PUT IN	PULLED OUT
				8-5/8"OD	210	None

Describe in detail the manner in which the well was plugged, indicating where the mud fluid was placed and the method or methods used in introducing it into the hole. If cement or other plugs were used, state the character of same and depth placed, from --- feet to --- feet for each plug set.

Filled w/heavy mud TD to 550' through drill pipe  
Set plug @ 550' w/20 sacks cement  
Filled w/heavy mud to 190' through drill pipe  
Set plug @ 190' w/20 sacks cement through drill pipe  
Filled w/heavy mud to 40' through drill pipe.  
Set plug @ 40' w/1/3 sack hulls and 10 sacks cement  
through drill pipe.

CONSERVATION DIVISION  
WICHITA, KANSAS  
10-15-1957

(If additional description is necessary, use BACK of this sheet)  
Name of Plugging Contractor Strata Drilling Inc.  
Address Great Bend, Kansas

STATE OF Kansas, COUNTY OF Rice, ss.  
Glen E. Armour (employee of owner) of the above-described well, being first duly sworn on oath, says: That I have knowledge of the facts, statements, and matters herein contained and the log of the above-described well as filed and that the same are true and correct. So help me God.

(Signature) Glen E. Armour  
(Address)

SUBSCRIBED AND SWORN TO before me this 14 day of October 19 57

Notary Public. [Signature]

My commission expires May 20, 1958

36 13 176  
BOOK PAGE 47 LINE 44

DRILLERS LOG

#1 KUHN

CASING RECORD: 212' of new 8-5/8" at 212', Cemented with 100 Sacks cement & 2% calcium chloride.  
 COMPANY: Tennessee Gas Transmission Co.  
 LOCATION: NW NW SW Sec. 36-13S-17W Ellis County, Kansas  
 CONTRACTOR: Strata Drilling Co.  
 COMMENCED: September 3, 1957  
 COMPLETED: September 14, 1957  
 ELEVATION:  
 TOTAL DEPTH: 3595'  
 D. & A.

<u>FORMATION</u>	<u>FROM</u>	<u>TO</u>	<u>REMARKS</u>
Surface Soil and Sand	0	60	
Shale and Shell	60	209	
Shale and Sand	209	850	
Red Bed	850	1025	
Red Bed	1025	1135	
Shale and Shell	1135	1800	
Lime and Shale	1800	3065	
Lime	3065	3546	
Lime and Shale	3546	3550	
Chert and Shale	3550	3595	Electric Log
TOTAL DEPTH	3590	KB	

I certify that this is a true and correct copy of the above log to the best of my knowledge.

STRATA DRILLING, INC.

*Charles W. Steincamp*  
 Charles W. Steincamp, President

Subscribed and sworn to before me this 22th day of October, 1957.

*Robert E. Southern*  
 Notary Public

My Commission Expires:  
 November 9, 1959

STATE OF KANSAS )  
 ) SS.  
 COUNTY OF BARTON)

10-24-1957

INDEXING  
 REC 36 13 R 174  
 300M MAR 27 1957