

STATE OF KANSAS  
STATE CORPORATION COMMISSION

WELL PLUGGING RECORD  
OR  
FORMATION PLUGGING RECORD


Strike out upper line  
when reporting plug-  
ging off formations.

Give All Information Completely  
Make Required Affidavit  
Mail or Deliver Report to:  
Conservation Division  
State Corporation Commission  
800 Bitting Building  
Wichita, Kansas

Ellis County, Sec. 36 Twp. 13S Rge. (E) 17 (W)

Location as "NE 1/4 NW 1/4 SW 1/4" or footage from lines Center of N/2 NE SE  
Lease Owner Gulf Oil Corporation  
Lease Name John F. Arnhold Well No. 1  
Office Address Box 661, Tulsa, Oklahoma  
Character of Well (Completed as Oil, Gas or Dry Hole) Dry Hole  
Date, well completed July 17, 1940 193  
Application for plugging filed July 18, 1940 193  
Application for plugging approved July 18, 1940 193  
Plugging Commenced July 18, 1940 193  
Plugging Completed July 19, 1940 193  
Reason for abandonment of well or producing formation Dry Hole

NORTH

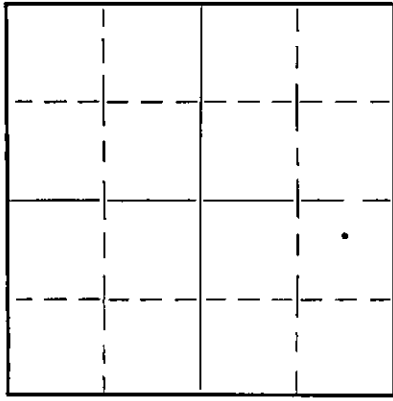

Locate well correctly on above  
Section Plat

If a producing well is abandoned, date of last production --- 193  
Was permission obtained from the Conservation Division or its agents before plugging was com-  
menced? Yes

Name of Conservation Agent who supervised plugging of this well C. T. Alexander, Great Bend, Kansas  
Producing formation Depth to top Bottom Total Depth of Well 3604 Feet  
Show depth and thickness of all water, oil and gas formations.


OIL, GAS OR WATER RECORDS

CASING RECORD

Formation	Content	From	To	Size	Put In	Pulled Out
				13"	171'	None

Describe in detail the manner in which the well was plugged, indicating where the mud fluid was placed and the method or methods used in introducing it into the hole. If cement or other plugs were used, state the character of same and depth placed, from feet to feet for each plug set.

Filled hole to bottom of surface casing at 170' with mud. Bridged hole with 13" OD Halliburton Plug, with 2' crushed rock on top of Plug. Dumped 12 sacks cement from 168' to 153'. Filled with mud to within 6' of bottom of cellar, and capped with 14 sacks cement.

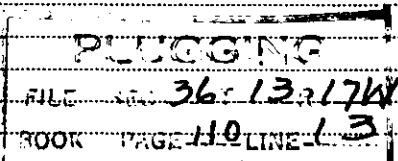

07-30-1940

(If additional description is necessary, use BACK of this sheet)

Correspondence regarding this well should be addressed to Gulf Oil Corporation  
Address Box 661, Tulsa, Oklahoma

STATE OF Kansas, COUNTY OF Rice, ss.  
O. L. Stevenson (employee of owner) of the above-described well,

being first duly sworn on oath, says: That I have knowledge of the facts, statements, and matters herein contained and the log of the above-described well as filed and that the same are true and correct. So help me God.

(Signature) O. L. Stevenson  
Chase, Kansas  
(Address)

SUBSCRIBED AND SWORN to before me this 25 day of July, 1940

My commission expires Aug 29, 1943  
Notary Public

WELL NO. 1 LEASE John F. Arnhold COMPANY Gulf Oil Corporation A.F.E. 3802  
 DATE—DRILLING BEGAN 6-27-40 WELL COMPLETED 7-19-40 FIRST PRODUCTION None  
 SAND RECORD Arbuckle Lime, 3541' - 3604' TOTAL DEPTH 3604'  
 INITIAL PRODUCTION "DRY HOLE"

CASING RECORD

S-36 T-138 R-17#

SIZE	WEIGHT	THD.	CLASS	MAKE	SET AT DEPTH	SACKS CEMENT	LBS. CAL. CHLO.	PULLED	LEFT IN
13"	50	8	SH	Lapw. St.	150'	125	200	--	150'

Ellis County,									
Kansas									
Center									0
N/2 NE									
SE									

(\*) "F." FLOWING NATURALLY; "L." AIR GAS LIFT; "S." SWABBING; "P." PUMPING.

ELEVATION— DP 1975'

TOP: Conglomerate 3503'.  
 Plugged and Abandoned on AFE 3833.

26 13 174  
 110 13

07-30-1946

0' to 25' Yellow surface clay  
 50 Sand  
 150 Blue shale  
 160 Blue shale & shells  
 190 Shale & shells  
 330 Bluemshale  
 355 Sand  
 632 Gray & blue shale  
 780 Broken sand  
 965 Gray & blue shale  
 1020 Blue & brown shale  
 1060 Shale & shells  
 1120 Shale & shells  
 1170 Anhydrite  
 1212 Blue shale & shells  
 1375 Shale & shells  
 1390 Anhydrite  
 1425 Shale & shells  
 1470 Blue shale & shells  
 1710 Salt & shells  
 1820 Shale & shells  
 1880 Lime & shale  
 1937 Anhydrite & lime  
 2005 Lime  
 2040 Lime & shale streaks  
 2100 Broken lime  
 2220 Lime  
 2247 Lime & shale breaks  
 2297 Lime & blue shale breaks  
 2350 Lime & shale streaks  
 2420 Lime & shale  
 2455 Lime  
 2515 Lime & small shale streaks  
 2528 Shale & shells  
 2620 Lime & shale  
 2658 Lime & gray shale breaks  
 2690 Lime & shale  
 2711 Shale  
 2715 Lime & shale streaks  
 2850 Lime & shale  
 2884 Lime  
 2944 Lime shells & shale  
 2958 Shale  
 2962 Lime  
 3023 Lime & shale breaks  
 3100 Lime  
 3140 Cherty lime  
 3282 Lime  
 3286 Broken lime  
 3418 Lime  
 3435 Hard lime  
 3507 Lime  
 3517 Lime & red shale  
 3604 Lime

TOTAL DEPTH