


WELL PLUGGING RECORD

Give All Information Completely  
Make Required Affidavit  
Mail or Deliver Report to:  
Conservation Division  
State Corporation Commission  
800 Bittling Building  
Wichita, Kansas

NORTH

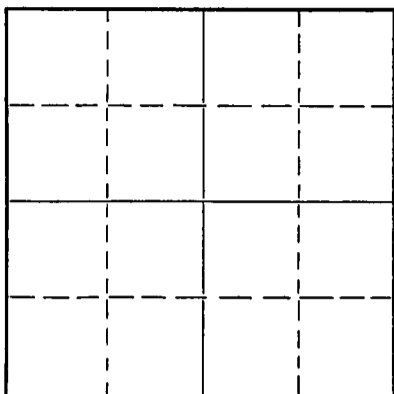

Locate well correctly on above  
Section Plat

Ellis County. Sec. 25 Twp. 13S Rge. 17 ~~XX~~ (W)  
Location as "NE/CNW $\frac{1}{4}$ /SW $\frac{1}{4}$ " or footage from lines SE SE NE  
Lease Owner Anschutz Drilling Company, Inc. & Rean Oil Co.  
Lease Name Rome Well No. 1  
Office Address 709 Union National Bank Bldg., Wichita, Kansas  
Character of Well (completed as Oil, Gas or Dry Hole) Dry Hole  
Date well completed 2/2 19 51  
Application for plugging filed 2/2 19 51  
Application for plugging approved 2/2 19 51  
Plugging commenced 2/2 19 51  
Plugging completed 2/2 19 51  
Reason for abandonment of well or producing formation Dry

If a producing well is abandoned, date of last production --- 19  
Was permission obtained from the Conservation Division or its agents before plugging was commenced? Yes

Name of Conservation Agent who supervised plugging of this well C. D. Stough, Great Bend, Kansas  
Producing formation --- Depth to top --- Bottom --- Total Depth of Well 3543 Feet  
Show depth and thickness of all water, oil and gas formations.

OIL, GAS OR WATER RECORDS

CASING RECORD

Formation	Content	From	To	Size	Put In	Pulled Out
				8-5/8"	247'	---

Describe in detail the manner in which the well was plugged, indicating where the mud fluid was placed and the method or methods used in introducing it into the hole. If cement or other plugs were used, state the character of same and depth placed, from --- feet to --- feet for each plug set.

Bottom plug set at 240' with 15 sacks cement.  
Top plug set at 40' with 10 sacks cement.

02-12-1951

(If additional description is necessary, use BACK of this sheet)  
Correspondence regarding this well should be addressed to Anschutz Drilling Company, Inc.  
Address 709 Union National Bank Bldg., Wichita, Kansas

STATE OF Kansas, COUNTY OF Sedgwick, ss.  
M. W. Smith (employee of owner) or (owner or operator) of the above-described well,  
being first duly sworn on oath, says: That I have knowledge of the facts, statements and matters herein contained and the log of the above-described well as filed and that the same are true and correct. So help me God.

(Signature) *M. W. Smith*  
709 Union National Bank Bldg., Wichita, Ks.  
(Address)

SUBSCRIBED AND SWORN to before me this 8th day of February 19 51  
*Patricia Meeker*  
Patricia Meeker Notary Public.

My commission expires January 21, 1954.

PLUGGING  
FILE SEC 25 T 13 R 17  
PAGE 60 LINE 1

DRILLER'S LOG  
 REAN OIL COMPANY, INC. AND ANSCHUTZ DRILLING  
 #1 ROME  
 SE SE NE SECTION 25-13S-17W  
 ELLIS COUNTY, KANSAS

0	70	Surface clay, sand & shale
70	247	Shale & shells
247	300	Shale & shells
300	600	Shale & shells
600	780	Sand
780	910	Shale & shells
910	1115	Shale & shells
1115	1145	Anhydrite
1145	1155	Anhydrite
1155	1400	Red Bed
1400	1510	Shale & shells
1510	1810	Shale & shells
1810	1920	Lime & shale
1920	2040	Lime & shale
2040	2135	Lime & shale
2135	2230	Lime & shale
2230	2305	Lime & shale
2305	2370	Lime & shale
2370	2480	Lime & shale
2480	2520	Lime & shale
2520	2550	Shale & shells
2550	2675	Shale & shells
2675	2815	Shale & shells
2815	2920	Shale & shells
2920	2940	Shale & shells
2940	2985	Lime & shale
2985	3040	Lime & shale
3040	3100	Lime & shale
3100	3150	Lime & shale
3150	3205	Lime & shale
3205	3275	Lime
3275	3330	Lime
3330	3370	Lime
3370	3409	Lime
3409	3460	Lime
3460	3500	Lime
3500	3543	Conglomerate
3543		ROTARY TOTAL DEPTH

COMMENCED: 1/22/51  
 COMPLETED: 2/2/51

TOPS:

Heeb. 3196 (-1230)  
 Tor. 3216  
 Lans. 3245  
 Cong. 3497  
 TD 3543 In Cong.

CASING RECORD:

Set 8-5/8" surface casing  
 @ 247' with 150 sacks of  
 cement and 1 CC.

D & A  
 Plugged

STATE OF KANSAS )  
 ) SS  
 COUNTY OF SEDGWICK )

I hereby affirm that the above and foregoing is a true and correct copy of the log of the #1 Rome located in the SE SE NE of Section 25-13S-17W, Ellis County, Kansas.

ANSCHUTZ DRILLING COMPANY, INC.

BY: *M. W. Smith*  
 M. W. Smith

Subscribed and sworn to before me this 8th day of February, 1951.

*L. J. Decker*  
 Notary Public

My commission expires January 21, 1954.

FILE SEC 25-13S-17W  
 PAGE 6-1