


Give All Information Completely  
Make Required Affidavit  
Mail or Deliver Report to:  
Conservation Division  
State Corporation Commission  
211 No. Broadway  
Wichita, Kansas

WELL PLUGGING RECORD

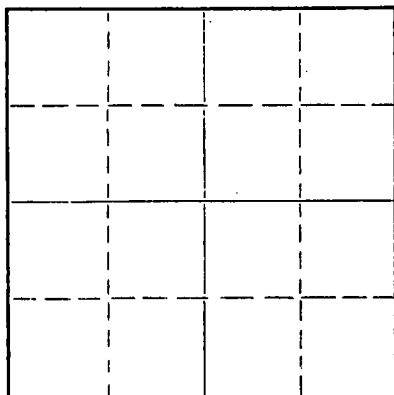

Locate well correctly on above Section Plat

Ellis County, Sec. 25 Twp. 13 Rge. 17 (E) (W)  
Location as "NE/CNW/SW" or footage from lines NW SW NW  
Lease Owner Woodman & Iannitti Drilling Co.  
Lease Name Braun Well No. 1  
Office Address P. O. Box 387, Hoisington, Kansas  
Character of Well (completed as Oil, Gas or Dry Hole) Dry Hole  
Date well completed 12-22 1957  
Application for plugging filed 12-22 1957  
Application for plugging approved 12-22 1957  
Plugging commenced 12-22 1957  
Plugging completed 12-22 1957  
Reason for abandonment of well or producing formation Dry.

If a producing well is abandoned, date of last production 19  
Was permission obtained from the Conservation Division or its agents before plugging was commenced? Yes.

Name of Conservation Agent who supervised plugging of this well Eldon Petty  
Producing formation \_\_\_\_\_ Depth to top \_\_\_\_\_ Bottom \_\_\_\_\_ Total Depth of Well 3584 Feet  
Show depth and thickness of all water, oil and gas formations.

OIL, GAS OR WATER RECORDS

CASING RECORD

FORMATION	CONTENT	FROM	TO	SIZE	PUT IN	PULLED OUT
				8 5/8"	164'	

Describe in detail the manner in which the well was plugged, indicating where the mud fluid was placed and the method or methods used in introducing it into the hole. If cement or other plugs were used, state the character of same and depth placed, from \_\_\_\_\_ feet to \_\_\_\_\_ feet for each plug set.

Filled pits with heavy rotary mud. Set bottom plug @ 500' with 20 sacks, middle plug @ 155' with 15 sacks & 1/3 sack of hulls, top plug @ 40' with 1/3 sack of hulls, 10 sacks of cement.

RECEIVED  
12-26-1957  
Wichita, Kansas

(If additional description is necessary, use BACK of this sheet)

Name of Plugging Contractor Woodman & Iannitti Drilling Company  
Address P. O. Box 387, Hoisington, Kansas


STATE OF KANSAS, COUNTY OF SEDGWICK, ss.  
K. T. Woodman (employee of owner) (owner or operator) of the above-described well, being first duly sworn on oath, says: That I have knowledge of the facts, statements, and matters herein contained and the log of the above-described well as filed and that the same are true and correct. So help me God.

(Signature) R. T. Woodman  
717 Union National Bldg., Wichita 2, Kansas  
(Address)

SUBSCRIBED AND SWORN TO before me this 22nd day of December, 1957

Mildred E. Lick  
Mildred E. Lick, Notary Public.

My commission expires March 15, 1961

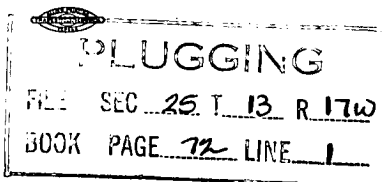

DRILLING LOG

Company: Woodman & Iannitti and Alpine Oil & Royalty

Lease: #1 Braun - NW SW NW Sec. 25-13-17W  
Ellis County, Kansas

Contractor: Woodman & Iannitti Drilling Company  
P. O. Box 387, Hoisington, Kansas

Date Commenced: 12-13-57

Date Completed: 12-22-57

Total Depth: 3584'

Casing: 8 5/8" set at 164' with 115 sacks of cement.

Figures Indicate the Bottom of Formation

0-70	Shale & Sand	2565	Lime & Shale
164	Shale	3045	Shale & Lime
445	Shale - Shells	3115	Lime
660	Clay, streak of sand	3540	Lime
820	Sand	3584	Conglomerate
975	Shale - Redbed		
1165	Redbed		
1200	Anhydrite		
1735	Shale & Shells		
1920	Lime & Shale		
2350	Lime		
2450	Lime & Shale		
2480	Lime		

GEOLOGICAL TOPS

Elevation	1984
Dakota Sand	660-820 (driller)
Anhydrite	1165 (driller) /819
Topeka	2989 -1005
Heebner	3236 -1252
Torento	3255 -1271
Lansing	3284 -1300
B/KC	3531 -1547
Cong..	3540 -1556
Total Depth	3584 -1600

I certify the above to be a true and correct copy of the Driller's Log and Geological Tops to the best of my knowledge and belief.

**RECEIVED**

STATE OF KANSAS

WOODMAN & IANNITTI DRILLING CO.

By:

*K. T. Woodman*

K. T. Woodman

DEC 26 1957  
12-26-1957  
CONSERVATION DIVISION  
Wichita, Kansas

PLUGGING	
FILE	SEC. 25 T. 13 R. 17W
BOOK	PAGE 72 LINE 1